

SURVEY NO. 8440

SURVEY NARRATIVE TO COMPLY WITH PARAGRAPH 209.250, OREGON REVISED STATUTES.

SURVEY FOR: Estremado Bros.
2585 Galls Cr. Rd.
Gold Hill, Or. 97525

LOCATION: Sec. 33, T. 36 S., R. 3 W.W.M. and Sec. 4 T. 37 S., R. 3 W.W.M., in Jackson County, Oregon.


PURPOSE: To locate and monument approximate property boundaries of the NW 1/4 of the SW 1/4, Sec. 33 and the NW 1/4 of the NW 1/4 of Sec. 4. Also, to locate and monument boundaries of shown mining claim as per deed records.

PROCEDURE: Found 5/8" steel pins at the West 1/4 cor. Sec. 33 and West in Sec. 32. I extend this line East 1320 feet for an approx. North line of said NW 1/4 of SW 1/4. Traversing South I find a 2" I.P. near the 1/16 cor. I then find Brass Caps at the NW cor. and the North and West 1/4 corners. I proportion the West line and split the North line and set 5/8" steel pins at the 1/16 corners. At the West 1/16 I blaze two trees: A 28" Oak bears S. 62° E. 9.37' and a 22" Oak bears N. 30° E. 21.0'. At the North 1/16 I blaze: A 12" Oak bears S. 85° W. 23.7' and a 10" Madrone bears S. 50° E. 18.6'. All distances regarding witness trees are measured to nails driven into the side of the tree.


BASIS OF BEARINGS: R.S. 3197

DATE COMPLETED: June 20, 1980.

Darrel W. Edwards
P.O. Box 801
Rogue River, Or. 97537
Ph: 582-3110

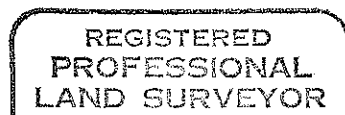

Darrel W. Edwards

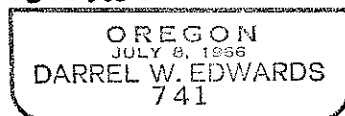

(TL 800) 36 SW 33
37 SW 4