


APPROX. S/L OF N. 1/2 OF NE 1/4 SEC. 36  
(SEC. 36 NOT LEGALLY SUBDIVIDED.)

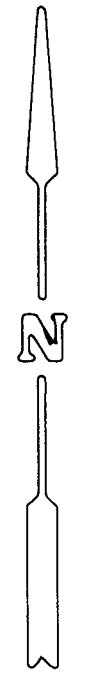

REGISTERED PROFESSIONAL LAND SURVEYOR  
*Darrel W. Edwards*  
 OREGON  
 DARREL W. EDWARDS  
 741



BASIS OF BEARINGS - RECORD SOUTH ON W/L SECTIONS 30 & 31.  
 S. 1/4 COR. SEC. 31 NOT FOUND. SET PINS ON APPROX. E/L GOV'T. LOT 2.

SURVEY FOR: DALE NYBERG AND JERRY CLYDE		
SCALE: 1" = 400'	● MONUMENTS FOUND	DRAWN BY DWL
DATE: MAY 27, 1980	○ 5/8" STEEL PINS SET	( ) RECORD MEAS.
LOCATION: NW 1/4 SEC. 31, T. 36 S., R. 3 W.W.M. NE 1/4 SEC. 36, T. 36 S., R. 4 W.W.M., JACKSON COUNTY, OREGON		
DARREL W. EDWARDS P.O. BOX 801, 98 PINE ST., ROGUE RIVER, ORE. 97537	PH 582-3110	DRAWING NUMBER

8456

8456

SURVEY NO. 8456

SURVEY NARRATIVE TO COMPLY WITH PARAGRAPH 209.250, OREGON REVISED STATUTES.

SURVEY FOR: Dale Nyberg and Jerry Clyde  
415 W. Walnut 504 Broadway  
Pasadena, CA. 91103 Rogue River, OR. 97537

LOCATION: In the NW 1/4 Sec. 31, T. 36 S., R. 3 W.W.M. and the NE 1/4 Sec. 36, T. 36 S., R. 4 W.W.M., in Jackson County, Oregon.

PURPOSE: To locate and monument property boundaries of the four 10.8 acre tracts and also the North line and approximate East line of the Clyde property as shown on the attached map and described in Official Records.



PROCEDURE: Using a TH 43 theodolite and a Lietz Red 1 EDM I made ties to the following Government Corners for control for survey as shown on the attached map.

Found a B.C. marking the W. 1/4 corner of Sec. 30, with bearing trees. Found B.C. marking the West 1/4 corner of Sec. 31, with bearing trees. Found B.C. marking the North 1/4 corner of Sec. 36, with bearing trees. Found B.C. marking the North 1/4 corner of Sec. 31, with bearing trees. Found squared stake in a mound of stones marking the East 1/4 corner of Sec. 31, both original bearing trees standing. Made a diligent search for the Northwest Corner of Sec. 31. No evidence of said corner or accessories could be found. Consulted Mr. Dillon, who has lived in the SE corner of Sec. 25 for many years and he stated that the trees were cut and the stumps have been uprooted or have rotted away. Mr. Dillon could not witness the exact location of said corner common to Secs. 25, 30, 31, and 36. However, to the best of his recollection the corner fell West of the B.W.M. access road. I therefore reestablished the Section Corner common to Secs. 25, 30, 31 and 36 by single proportion measurement along the Range line between T. 36 S., R. 3 W. and T. 36 S., R. 4 W. of the Willamette Meridian. I referenced said corner as follows: NE corner of a well house 37.69' N. 84° W., nail in an 8" Madrone 17.00' N. 10° 30' E., a nail in a 6" oak 4.12' S. 38° 30' E., a nail in a 12" Madrone 4.05' S. 10° 45' W. Corners set in this survey are 5/8" steel pins 30" in length as shown on the attached map.


BASIS OF BEARINGS: Record South on the West lines of Secs. 30 and 31.

DATE COMPLETED: May 27, 1980.

Darrel W. Edwards  
P.O. Box 801  
Rogue River, Or. 97537  
Ph: 582-3110

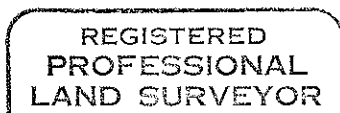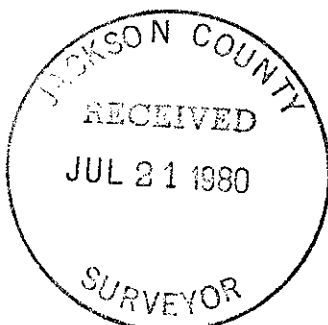

*Darrel W. Edwards*

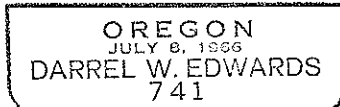

(TL 100) 36 4W 36  
(TL 201-203) 36 3W 31