

# SPRING STREET ESTATES - UNIT NO. 1

N.E. 1/4 SEC. 20, T. 37S., R. 1W., W.M.  
CITY OF MEDFORD  
JACKSON COUNTY, OREGON  
POST MONUMENTATION PLAT

8459

I, Verlyn Thomas, a duly Registered Land Surveyor of the State of Oregon, do hereby certify that this map represents a survey made by me or under my direction and the monuments conform to O.R.S. 92.060.

Examined and approved this 11<sup>th</sup> day of July, 1980.

Donald C. Walker  
City Engineer

Harold D. Deaver  
City Surveyor

Filed for record this 29<sup>th</sup> day of July, 1980 at 9:07 O'Clock A. m. and recorded in the Official Records of Jackson County, Oregon.

Waldene Terry  
County Clerk


Ruby A. Poling  
Deputy



Scale: 1" = 100'

### LEGEND

- Mon. Found
- 5/8" x 24" I. Pin Set
- 5/8" x 30" I. Pin Set
- ⊙ St. Mon. w/ B. Disc

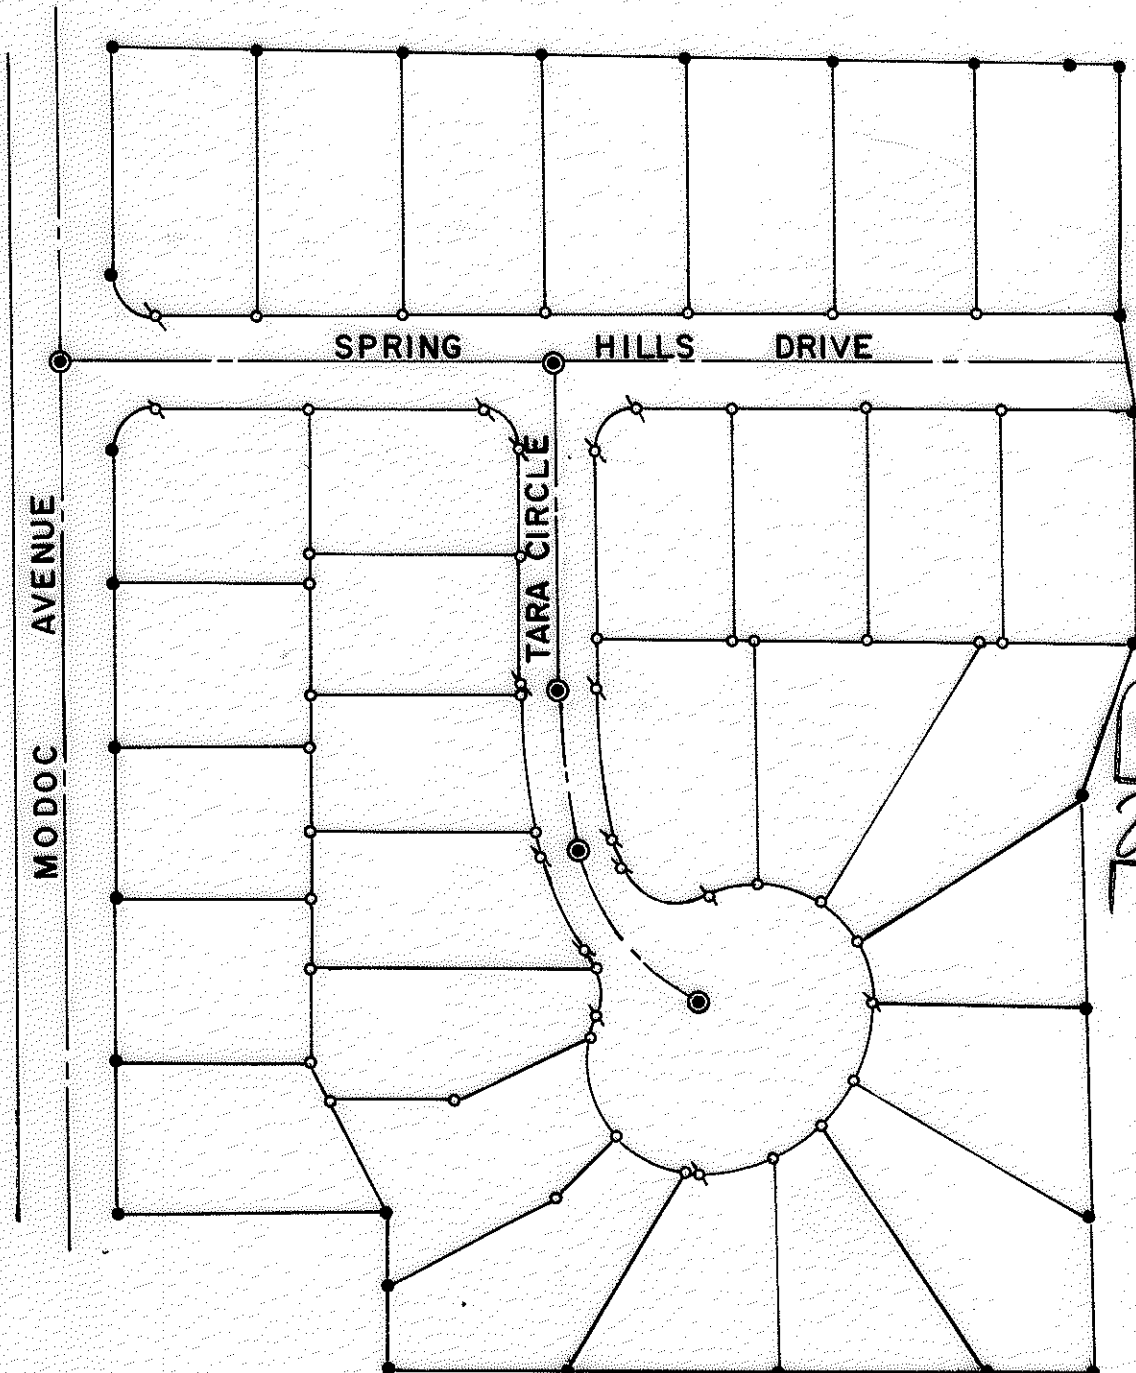

REGISTERED  
PROFESSIONAL  
LAND SURVEYOR

Verlyn Thomas  
OREGON  
MAY 13, 1960  
VERLYN D. THOMAS  
505

JACKSON COUNTY  
RECEIVED  
JUL 29 1980  
SURVEYOR

8459