


Scale 1 inch=100 feet

Basis of Bearings  
Survey No. 5530

79-28396 Jackson Co. deed records

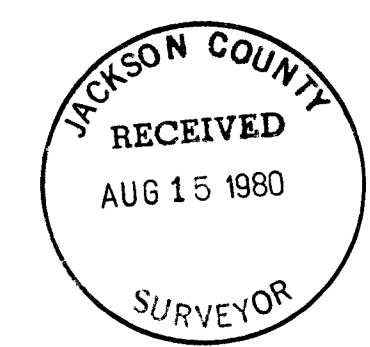

MAP OF SURVEY

For: Thomas L. Ciota, Klamath Falls, Oregon

Located in: NW 1/4, Section 21, T. 40S., R. 2E., W.M., Jackson County, Oregon.

August, 1980

LEGEND

- Fd. 1-1/4 yellow plastic cap mkd. Burrell RLS 638
- Fd. 1-1/2 alum. cap mkd. O.S.H.D.
- Set 5/8" x 30" iron reinforcing pin with a yellow cap mkd. PIERSON OPLS 1650

Survey Number 8481

SURVEY NARRATIVE TO COMPLY WITH O.R.S. 209.250

FOR: Thomas L. Ciota  
2234 Vine Street  
Klamath Falls, Oregon 97601

PURPOSE: To establish the north and south line of the memorandum of land sale contract number 79-28396 of Jackson County Deed Records.

PROCEDURE: From the above said description it became obvious that the partial retracement of parcel number 2 of registered survey number 5530 would control the location of said description.

The nine (9) monuments I set reflect the above said control except as per instruction of my client; I did not verify the easterly right-of-way of Interstate 5, but from the east set two (2) monuments at record calls from the above said description. These said monuments, near the easterly right-of-way of Interstate 5, should be considered "Line Monuments" only.

During this survey I verified that the north-west corner of section 21 was in evidence. I found said corner to be in good condition.

August 13th, 1980

