

# SURVEY FOR BOISE CASCADE CORP.

P.O. BOX 100, MEDFORD, OREGON

## SECTION 22, T.33S., R.1E., W.M.

Scale: 1" = 400'

August, 1980

T.33S. R.1E.

SEC 15 14 COR  
22 23

1963  
T.33S. R.1E.

16 | 15

### Northwest Corner Section 22

Found 1" G.I.P. with 1/2" to 1" bell reducer filled with pot metal projecting 24" above the ground; marked as shown

#### B.T.'s Found

- 10" D.F., brs. N12°E, 16.0', B.&H.
- 10" Oak, brs. S22°E, 43.7', B.&H.
- 12" D.F., brs. S63°N, 8.7', B.&H.
- 12" D.F., brs. N12°W, 23.4', B.&H.
- 16" Oak, brs. N57°E, 12' chopped out, S.V.
- 30" Oak stump, brs. S70°E, 48.5', rotten, no marks
- 10" Oak snag, brs. S82°N, 16.0' chopped out, S.V.

516 515  
521 522

### Northeast Corner Section 22

Found 1/4" iron pipe, projecting 3" above the ground, with a brass cap marked as shown

#### B.T.'s Found

- 54" Fir stump, brs. S75°E, 25.7', B.&H.
- 13" Fir stump, brs. S12°W, 31', S.V.
- 12" Fir, brs. N23°E, 51.0', B.&H.
- 29" Fir stump, brs. S64°E, 42.5', B.&H.
- 10" Fir, brs. S67°W, 51.5', B.&H.
- 16" Cedar, brs. N38°W, 40.1', B.&H.

(G.L.O. N89°31'W 40.25chs. 1856)

515 514  
522 523

### North 1/4 Corner Section 22 (Note 4)

Set 2 1/2" x 30" aluminum pipe, 18" in the ground with a 2 1/2" aluminum cap marked as shown.

#### B.T.'s Marked

- 14" D.F., brs. N28°40'N, 35.8', scribed; T.33S. R.1E. 1/4 515 BT
- 7" D.F., brs. S33°45'N, 84.1', scribed; T.33S. R.1E. 1/4 522 BT

516 515  
522 522

Solar Observation  
July 23, 1980

BOISE CASCADE CORP.  
N.E. 1/4  
163.8 Acres

### CE 1/16 Corner Section 22

Found 3" aluminum cap on a 2 1/2" aluminum pipe, projecting 8" above the ground at the proportioned position; cap marked as shown.

#### B.T.'s Marked

- 14" B. Oak, brs. N11°20'E, 33.4', scribed; T.33S. R.1E. CE 1/16 522 BT
- 12" P. Pine, brs. S89°0'N, 66.8', scribed; T.33S. R.1E. CE 1/16 522, BT

(U.S. Corps of Engin-  
cers monument)  
1979

1963  
T.33S. R.1E.  
21 | 22  
1/4 COR  
RS 583

### East 1/4 Corner Section 22

Found 1/2" bell reducer flush with the ground, filled with pot metal; marked as shown.

#### B.T.'s Found

- 12" D.F., brs. N41°05'E, 41.7', B.&H.
- 9" D.F., brs. S84°45'N, 16.4', B.&H.

521 522

C 1/4 522  
Not Monumented

CE 1/16

522 523

BOISE CASCADE CORP.  
N. 1/2 S.W. 1/4  
81.7 Acres

BOISE CASCADE CORP.  
W. 1/2 S.E. 1/4  
81.0 Acres

### East 1/4 Cor. Sec. 22

Found a standard B.L.M. monument, projecting 3" above the ground with a brass cap marked as shown.

#### B.T.'s Found

- 10" D.F., brs. N25°55'E, 31.7', B.&H.
- 12" D.F., brs. N88°30'N, 46.0', B.&H.

### E 1/16 Cor. Sec. 22

Found a standard B.L.M. monument in a mound of stones, marked as shown.

#### B.T.'s Found

- 8" I. Cedar, brs. N10°20'E, 14.9', S.V.
- 12" D.F., brs. S38°10'E, 12.3', S.V.

### Legend

- (1) Data of record; ref. (G.L.O. Plat - July 7, 1856) (B.L.M. Plat - January 21, 1980)
- (2) Set monument
- (3) Found monument
- (4) Blazed & painted property line
- (5) Set 1/2" x 1/2" aluminum tags stamped P/L B.C.C. at intervals < 300'
- (6) Creek
- (7) Ridge
- (8) B.&H. Blazed & Healed - on B.T.'s
- (9) S.V. Scribing Visible - on B.T.'s

### Notes

- (1) U.S. Corps of Engineers 3" aluminum caps, N.E. 22-1 to 22-20 are located within 1ft. of true line along the west and North boundary lines of the E 1/2 of the S.E. 1/4, Sec. 22.
- (2) Bearing Base: Solar observation at the position noted in the N.W. 1/4 Sec. 22.
- (3) All bearing tree faces painted red and with a 6" band of red paint at approximately 5' to 6' above base.
- (4) The G.L.O. Plat approved July 7, 1856 was used as the basis to proportion the position of North 1/4 Corner of section 22. I declared this corner to be lost after a thorough search of the area produced no evidence of the original corner.

### South 1/4 Corner Section 22

Found a standard B.L.M. monument in a mound of stones, with a brass cap marked as shown

#### B.T.'s Found

- 14" I. Cedar, brs. N00°50'E, 8.0', S.V.
- 6" D.F., brs. S45°10'E, 30.8', S.V.

T.33S. R.1E.  
1/4 522  
1974  
Cadastral Survey

### Southwest Corner Section 22

Found 1" G.I.P. projecting 21" above the ground, with a 1/2" bell reducer filled with pot metal marked as shown.

#### B.T.'s Found


- 12" D.F., brs. N34°50'E, 19.4', B.&H.
- 16" D.F., brs. S29°50'E, 14.5', B.&H.
- 8" D.F., brs. S68°00'E, 18.0', B.&H.
- 12" D.F., brs. N38°10'W, 6.6', B.&H.

Found stump holes and windfalls at positions of original B.T.'s - No scribing found at any of the positions

REGISTERED  
PROFFSSIONAL  
LAND SURVEYOR

Malcolm N. Clark

OREGON  
JULY 12, 1963  
MALCOLM N. CLARK  
601

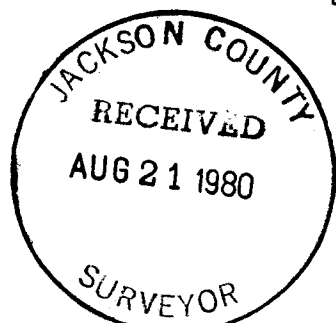

### SURVEY BY:

Chickering-Green Empire, Inc.  
360 S.E. H Street  
Grants Pass, Oregon

8490

Survey Number

Survey Narrative to Comply with O.R.S. 209.250

Survey for: BOISE CASCADE CORPORATION  
P.O. Box 100  
Medford, OR 97501

Survey by: CHICKERING/GREEN EMPIRE, INC.  
360 S.E. "H" Street  
Grants Pass, OR 97526  
(Malcolm N. Clark, RLS 601)

Location: Section 22, T33S, R1E, W.M.

Purpose: To mark certain property lines and establish certain property corners of Boise Cascade Corporation's lands.

Equipment: Wild T-16 and K & E AutoRanger

Procedure: A closed traverse was run between the controlling corners of Section necessary to subdivide the section. Bearings are based on a solar observation in the E 1/4 of Section 22.

After a thorough search for original evidence of the North 1/4 corner of Section 22, and finding none, I declared the corner lost and by single proportionate measurement, using the GLO plat of 1856 as a basis, I determined a position to reestablish the corner.


The section was then subdivided according to the BLM Manual for the Survey of Public Lands and necessary property corners set. Certain property lines were then blazed and painted. Those property lines were also marked by posting 1 1/2" by 5" Aluminum tags at intervals less than 300 feet.

Date: August 12, 1980.

REGISTERED  
PROFESSIONAL  
LAND SURVEYOR

*Malcolm N. Clark*

OREGON  
JULY 12, 1963  
MALCOLM N. CLARK  
601

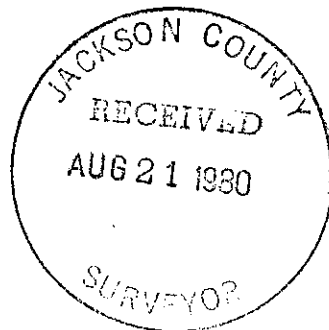

33, 1E, 22