

**CENTERLINE SURVEY FOR A
ROADWAY EASEMENT**

LOCATED WITHIN THE SE 1/4 OF THE NW 1/4 OF SECTION 4,
T.36 S., R.1 E., W.M., JACKSON CO.,
OREGON


BASIS OF BEARING - RECORDED SURVEY NO. 7873

SURVEY FOR - BROWNSBORO CEMETERY ASSOCIATION
c/b 4025 BROWNSBORO HIGHWAY
EAGLE POINT, OREGON 97524

SURVEY BY - JACKSON COUNTY SURVEYOR'S OFFICE
ROOM 305 COURTHOUSE
MEDFORD, OREGON 97501

DATE - AUGUST 22, 1980

SCALE - 1" = 50'

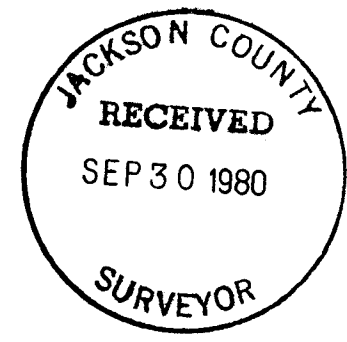

LEGEND

- FOUND 1" GALV. IRON PIPE PER REC. SURVEY 7873
- FOUND 5/8" REBAR WITH PLASTIC CAP MARKED AS SHOWN
- SET 5/8" REBAR, LENGTH AS SHOWN
- CENTERLINE, TO BE DESCRIBED
- REF. P.I. REFERENCE CURVE P.I. FOR EXISTING ROAD CENTERLINE
- R.S. RECORDED SURVEY

NOTE

BASIS OF BEARING - MONUMENTS OF R.S. 7873, PROJECT NO. 79-10, USED:
P-K NAIL IN PAVEMENT OF ACCESS APPROACH (S'LY) ROAD, ORE. HWY. 140, POINT 'C-1'
NEAR BROWNSBORO-EAGLE POINT ROAD JUNCTION TO
5/8" REBAR AT CEMETERY, CCP-1', N.75° & E. 9' FROM THE SW FENCE CORNER
OF THE CEMETERY N 34° 40' 51" E, 2265.31 FEET

NOTE
P.C. OF CURVE = POINT OF BEGINNING OF THIS CENTERLINE SURVEY AND DOCUMENT RECORDED IN OFFICIAL RECORDS 80-16664 = POINT ON N-S CENTERLINE OF SEC. 4

P.O.B. = N0°15'50"W, 662.14'
FROM C 1/4 OF SEC. 4, 36-1E
DEED (O.R. 80-16664) RECORD
MEAS. N0°16'12"W

FOUND SPIKE
RIGHT-OF-WAY SE'LY TO
OBENCHAIN ROAD, SEE
O.R. 80-16664

○ C 1/4 R.S. 7873

REGISTERED
PROFESSIONAL
LAND SURVEYOR

JERRY R. SWANSON
760

8531

SURVEY NARRATIVE TO COMPLY WITH O.R.S. 209.250

SURVEY FOR: Brownsboro Cemetery Association

SURVEY BY: Jackson County Surveyor's Office
Project No. 80-11

PURPOSE OF THIS SURVEY: To locate, monument and re-describe by centerline that certain existing road easement as granted in O.R. 77-18727 from Gerald and Margaret Hansen to the Brownsboro Cemetery Association.

PROCEDURES: From survey controls in the area per Recorded Survey No. 7873 and same as amended and recorded as Recorded Survey No. 8530, set iron rebars at centerline P.I.'s (point of intersections) along the existing road, traversed same and calculated curve and tangent data as shown on the accompanying map to prepare centerline easement description.

BASIS OF BEARING: Recorded Survey No. 7873.

EQUIPMENT USED: Kern one-second Theodolite; Geodimeter 76 EDM.

September 30, 1980

Jerry R. Swanson
P.L.S. 760
Deputy County Surveyor

