

8546

NE COR. GOV'T. LOT 4
NOT FOUND
(OBLITERATED)
SEE RS 1508

3/4" I. PIN

216.30'
107.70'

N. 59° 37' E.

108.80'

1/2" I. ROD

FIELDER LANE AS PAVED

WITNESS CORNER

HUB
ELEV. = 976.21

(SOUTH RS. 1508)
S. 51° 25' E. 109.104'

BASE BEARING
448.93'
S. 8° 30' E.

HUB
ELEV. = 974.45'

BASIS OF BEARINGS: R.S. 3866
DATUM: JACKSON COUNTY T.B.M.
REFERENCE MARK RM 1-3



3/4" I. PIPE
24" DEEP

ROGUE RIVER

(125')
N. 50° 21' E. 176.00'

3/4" I. PIPE
8" DEEP

SURVEY FOR: VAUGHN ELLIOTT

LOCATION: SE 1/4 SEC. 20, T. 36 S., R. 4 W. W.M.
JACKSON COUNTY, OREGON

DATE: SEPT. 24, 1980

SCALE: 1" = 60'

● MONUMENTS FOUND


○ 5/8" x 30" STEEL PIN SET

-x-x- FENCE LINE

REGISTERED
PROFESSIONAL
LAND SURVEYOR

Darrel W. Edwards

OREGON
JULY 8, 1966
DARREL W. EDWARDS
741

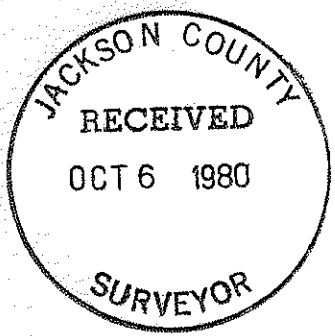

(TL 2000) 36 4W 20 D

8546

SURVEY No. 8546

SURVEY NARRATIVE TO COMPLY WITH PARAGRAPH 209.250, OREGON REVISED STATUTES.

SURVEY FOR: Vaughn Elliott
1628 Virginia Lane.
Grants Pass, Or. 97526

LOCATION: SE 1/4 Sec. 20, T. 36 S., R. 4 W.M.M., in Jackson County,
Oregon.

PURPOSE: To locate the property corners of Tax Lot 2000 in said Section
as monumented in R.S. 1508 and described in Official Records.

PROCEDURE: Found monuments from recorded surveys 1508 and 3866 as shown on
the attached map. I set a 5/8" steel pin on the East line of
subject property as monumented in R.S. 1508. I then run a bench
circuit using datum shown on the accompanying plat and set hubs
as shown.

BASES OF BEARINGS: R.S. 3866


DATE COMPLETED: Sept. 24, 1980.

Darrel W. Edwards
P.O. Box 801
Rogue River, Or. 97537
Ph: 582-3110

REGISTERED
PROFESSIONAL
LAND SURVEYOR

Darrel W. Edwards

OREGON
JULY 8, 1966
DARREL W. EDWARDS
741

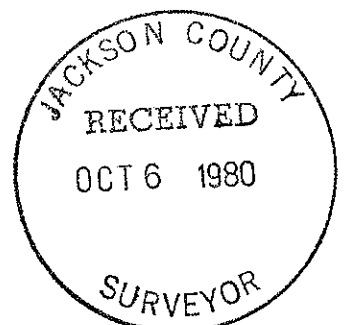

(71 200-) 36 4W 011