

8583

LOT 2 BLOCK 1

WEST 1099.86'
547.00'

5.00 AC. PARCEL

S 23° 19' 30" W
433.66'

LOT 3

LOT 4 BLOCK 1

WEST 547.00'

27.22'

RIGHT FORK OF FOOTS CREEK ROAD
S 23° 19' 30" W 433.66'
460.88'

WEST 1001.07'
BOUNDARY OF FRANTZ SUBDIVISION

MAP OF SURVEY

Located in
NE. 1/4 of SEC. 11, T. 37S., R. 4W., W.M.
JACKSON COUNTY, OREGON

FOR

"GIL CHABOT"

HOFFBUHR SURVEYING, INC. MEDFORD, OREGON

SCALE: 1"=100' OCTOBER 27, 1980
BASIS OF BEARING ----- FRANTZ SUBDIVISION
(By) RICHARD L. BATH ----- P.L.S. NO. 1069

- ⊙ = SET 5/8" X 24" IRON PIN (tagged "R. BATH L.S. 1069")
- = FOUND 5/8" IRON PIN (per recorded Subdivision)

JACKSON COUNTY
RECEIVED
NOV 7 1980
SURVEYOR

REGISTERED
PROFESSIONAL
LAND SURVEYOR

Richard L. Bath

OREGON
JULY 30, 1976
RICHARD L. BATH
No. 1069

37 4W 11 8583

SURVEY NO. 8583

SURVEY NARRATIVE TO COMPLY WITH PARAGRAPH 209.250
OREGON REVISED STATUTES

SURVEY FOR: Gil Chabot
5808 Abbie Lane
Gold Hill, Oregon 97525



LOCATION: Northeast one-quarter (1/4) of Section 11,
Township 37 South, Range 4 West, Willamette
Meridian, Jackson County, Oregon

PURPOSE: To partition Lot 3, Block 1 of Frantz Subdivision
in Jackson County, Oregon

PROCEDURE: Located exterior boundary of said Lot 3. Monument-
ed division line as shown on attached map.

Basis of Bearing--Lot 3, Block 1, Frantz Subdivision

October 31, 1980

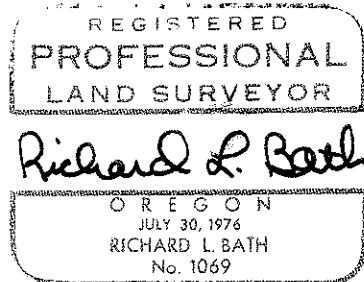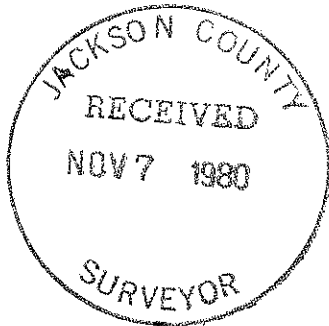

Richard L. Bath
Hoffbuhr Surveying, Inc.
219 North Oakdale
Medford, Oregon 97501