

SURVEY SUPPLEMENT TO SURVEY NO. 7835  
SHOWING RELATIONSHIP OF IMPROVEMENTS  
TO ESTABLISHED BOUNDARIES.

FD. STONE  
NW COR. D.L.C. 47  
(SURVEY 5359)

SURVEY SITUATE IN D.L.C. 48  
(SEC. 5) T. 37S., R. 2 W., W.M.  
JACKSON COUNTY, ORE.

FOR  
PAUL T. & ELEONORA O. RUTTER



N 0°14'50"E PER SURVEY 5359

FD. 5/8" IRON PIN  
(SURVEY 5359)

S 56°56'E DEED REC. 480.00'  
OLD

20' X 48' METAL BLDG.  
N 33°04'E DEED REC. 480.00'

65.7'  
-470.145'  
EAST 802.13'  
331.985'  
3.2'  
42.5'

SURVEY 7835

N 0°14'17"E  
739.67'

SURVEY BY  
CHARLES H. HURST  
MEDFORD, OREGON

LEGEND  
• FD. 5/8" IRON PINS  
-x- EXISTING FENCE LINES

REGISTERED  
PROFESSIONAL  
LAND SURVEYOR

*Charles H. Hurst*

OREGON  
OCTOBER 30, 1959  
CHARLES H. HURST  
483

JACKSON COUNTY  
RECEIVED  
NOV 21 1980  
SURVEYOR

NOV 12 1980

STAGE  
ROAD

SSE COR. D.L.C. 48  
1 1/2" IRON PIPE

372W5

8612

SURVEY NARRATIVE TO COMPLY WITH PARAGRAPH 209.250

OREGON REVISED STATUTES

Survey for: Dr. Paul T. Rutter &  
Eleonora O. Rutter  
4360 Old Stage Road  
Central Point, Oregon 97502

Survey by : Charles H. Hurst  
304 South Holly  
Medford, Oregon 97501



Bearings : Derived from Survey No. 1801, i.e. the centerline  
of Old Stage Road

Purpose : To locate existing improvements with respect to  
previously monumented boundaries.

Procedure

Existing fence and building corners were tied to the nearest  
monuments set during the course of Survey No. 7835.

November 12, 1980

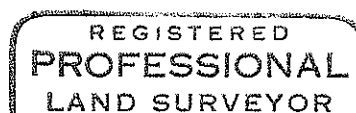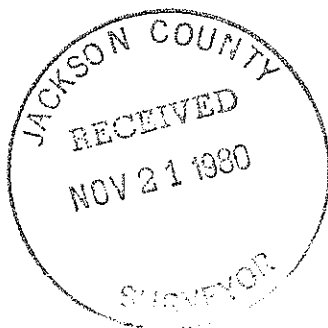

*Charles H. Hurst*

