


LEGEND:
 ● = FOUND MONUMENT AS SHOWN.
 ○ = SET 5/8" IRON PIN WITH PLASTIC CAP STAMPED, MOFFIT PLS 944.
 BASIS OF BEARINGS:
 SURVEY NO. 6165

PLAT OF SURVEY
 FOR
RICHARD & PAMELA BRATTHAUER
 BEING THE NORTH ONE-HALF OF THE SOUTHEAST ONE-QUARTER OF THE NORTHWEST ONE-QUARTER OF SEC. 21, TOWNSHIP 34 SOUTH, RANGE 1 WEST, W.M. JACKSON COUNTY OREGON
 SCALE: 1"=200'
 DATE: DEC., 1980
 PREPARED BY: FRIAR - MOFFIT AND ASSOCIATES

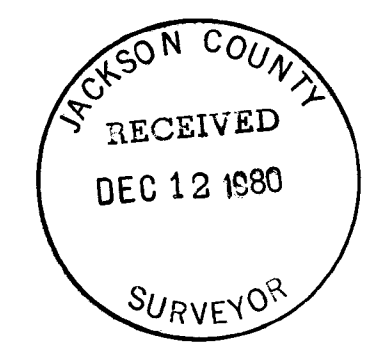

REGISTERED PROFESSIONAL LAND SURVEYOR
Lloyd R. Moffit
 OREGON JULY 22 1978
 LOYD R. MOFFIT 944

SURVEY NO. 8638

SURVEY NARRATIVE TO COMPLY WITH O.R.S. 209.250

SURVEY FOR: RICHARD AND PAMELA BRATTHAUER
102 BOND ROAD
SHADY COVE, OR 97539


LOCATION: THE NORTH ONE-HALF OF THE SOUTHEAST ONE-
QUARTER OF THE NORTHWEST ONE-QUARTER OF
SECTION 21, TOWNSHIP 34 SOUTH, RANGE 1
WEST, WILLAMETTE MERIDIAN, JACKSON COUNTY,
OREGON.

PURPOSE: TO SURVEY AND SET THE CORNERS OF THE CLIENT'S
PROPERTY.

PROCEDURE: FROM THE CONTROL ESTABLISHED DURING SURVEY
NO. 6782, I TRAVERSED TO THE NORTHWEST
CORNER AND TO THE WEST ONE-SIXTEENTH
CORNER ON THE NORTH LINE OF SAID SECTION
21. AFTER FRACTIONIZING THE NORTHWEST
ONE-QUARTER OF SAID SECTION 21, I SET THE
CORNERS AS SHOWN ON THE ATTACHED MAP.

DATE: DECEMBER, 1980

FRIAR-MOFFIT & ASSOCIATES
717 WEST 10TH, SUITE 1
MEDFORD, OR 97501
PHONE: 503-772-2782

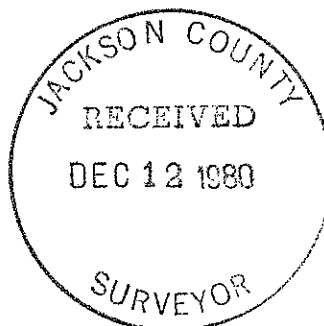

JOB #80-185

T.34S., R.1W., SECTION 21
TAX LOT 2400