


BASIS OF BEARINGS:
RS-6746

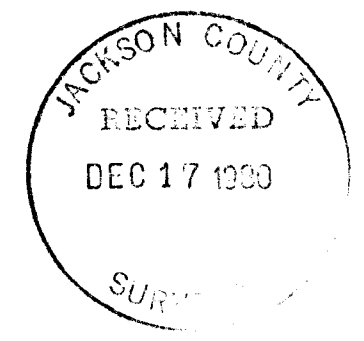

SURVEY FOR: FRIEDA HATCH	
LOCATION: FRACTION LOT 2, BLK. 3, WOODVILLE. SW 1/4 SEC. 15, T36S, R4W. W.M., JACKSON CO.	
DATE: DECEMBER 8, 1980	REGISTERED PROFESSIONAL LAND SURVEYOR <i>Darrell W. Edwards</i>
SCALE: 1" = 60'	
● MONUMENT FOUND	OREGON JULY 31, 1955 DARREL W. EDWARDS 741
○ 5/8" x 30" STEEL PIN SET	
() RECORD MEASUREMENT	

SURVEY NO. 8649

SURVEY NARRATIVE TO COMPLY WITH PARAGRAPH 209.250, OREGON REVISED STATUTES

SURVEY FOR: Frieda Hatch
% Margo Graham
15010 Hoerster Ln.
Rogue River, OR. 97537

LOCATION: Fraction Lot 2, Block 3, Woodville. SW 1/4 Sec. 15, T36S., RLW. W.M.
in Jackson County, Oregon.

PURPOSE: To locate and monument property boundaries as shown on the accompanying
plat and described in Official Records.

PROCEDURE: Found centerline control as monumented in R.S. 6746; Surveyed and
monumented said parcel as per deed records.

EQUIPMENT: Zeiss Th 43 Theodolite and Lietz Red-1 EDM.

BASIS OF BEARINGS: R.S. 6746

DATE COMPLETED: December 8, 1980

Darrel Edwards
P.O. Box 801
Rogue River, Oregon 97537
Ph. 582-3110

