


Basis of Bearings: RS 4849-A

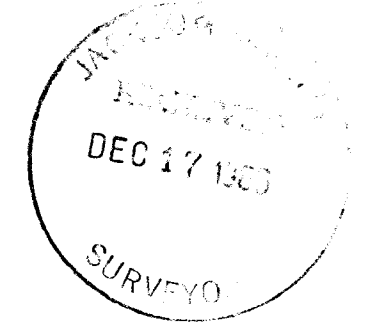

SURVEY FOR: NORMAN JONES & RICHARD McVEE	
LOCATION: S. 1/2, NE 1/4 SEC. 27, T. 35 S., R. 4 W. W.M. JACKSON COUNTY, OREGON	
DATE: NOVEMBER 20, 1980	SCALE: 1" = 400'
<ul style="list-style-type: none"> ● MONUMENTS FOUND ○ 5/8" x 36" STEEL PINS SET —x—x— FENCE LINE () RECORD MEASUREMENT 	<p>REGISTERED PROFESSIONAL LAND SURVEYOR</p> <p><i>Darrel W. Edwards</i></p> <p>OREGON JULY 8, 1980 DARREL W. EDWARDS 741</p>

SURVEY NO. 8651

SURVEY NARRATIVE TO COMPLY WITH PARAGRAPH 209.250, OREGON REVISED STATUTES

SURVEY FOR: Norman Jones and Richard McVee
18 11th Avenue
San Mateo, California 94401

LOCATION: NE 1/4 of Sec. 27, T35S., R14W., W.M. in Jackson County, Oregon.

PURPOSE: To locate and monument property boundaries of the Jones and McVee property as shown on the accompanying plat and described in Official Records.

PROCEDURE: I found the section monuments as shown on the accompanying plat. The North 1/4 Corner was found in agreement with the Pleasant Valley Farm Tracts and R.S. 3288. The East 1/4 Corner was not found but a possible original bearing tree was and upon re-establishing said corner it was located in agreement with a corner fence post. I then monumented the Jones and McVee property as shown on the accompanying plat.

Bearing trees were blazed as follows with distances to center of tree:

N 1/4 corner: 1 1/2" Madrone bears N35°W, 25.7 feet
9" Y. Pine bears S67°E, 27.8 feet

NW corner 5" D. Fir bears N5°W, 23.7 feet
S 1/2 NE 1/4: 19" Madrone bears S85°E, 2.5 feet

NE corner 12" Maple bears West, 6.6 feet
S 1/2 NE 1/4: 5" D. Fir bears N55°E, 9.3 feet

Center Section: 6" Madrone bears N9°W, 5.1 feet
8" Madrone bears S25°W, 5.7 feet


E 1/4 corner: 4" Oak bears N30°E, 4.1 feet
8" Madrone bears N73°E, 25.2 feet
Found Oak stump (deteriorated) S.59°W., 31 lks.

EQUIPMENT: Zeiss Th 43 Theodolite and Lietz Red-1 EDM


BASIS OF BEARINGS: R.S.4849-A

DATE COMPLETED: Nov. 20, 1980

Darrel W. Edwards
P.O. Box 801
Rogue River, OR 97537
Ph. 582-3110

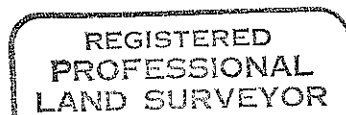

Darrel W. Edwards

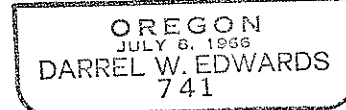

35 4W 27