


LEGEND:
● = FD. 5/8" IRON PIN
⊙ = SET 5/8" IRON PIN

MAP OF SURVEY
FOR
MEL ESPEN

LOCATED IN THE N.E. 1/4 OF SEC. 7,
T. 38 S., R. 4 W., WILLAMETTE MER.
JACKSON CO. OREGON
SCALE: 1" = 200'
DEC. 1980
BASIS OF BEARING: SURVEY NO. 4482
PREPARED BY: FRIAR-MOFFIT & ASSOC.
MEDFORD OREGON

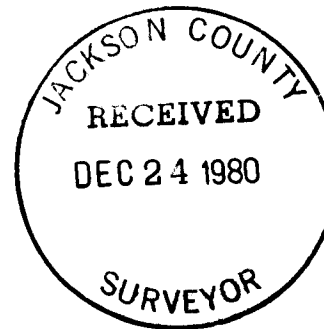

SURVEY NO. 8663

SURVEY NARRATIVE TO COMPLY WITH O.R.S. 209.250

SURVEY FOR: MEL ESPEN
8890 ROGUE RIVER HIGHWAY
GRANTS PASS, OR 97526

LOCATION: N.E. 1/4 SECTION 7, T. 38 S., R. 4 W.,
JACKSON COUNTY, OREGON.

PURPOSE: TO SURVEY AND MONUMENT THE WEST 1/2
OF THE N.W. 1/4 OF THE N.E. 1/4 OF
SECTION 7, T. 38 S., R. 4 W., W.M.

PROCEDURE: THE FRACTIONAL SECTION LINES RUN AND
MARKED AS SHOWN ARE DEPENDANT ON THE
SUBDIVISION OF THE SECTION BY SURVEY
NO. 4482. DURING THE EXECUTION OF
SURVEY NO. 5392 BY THIS OFFICE A
NUMBER OF CORNERS SHOWN ON SURVEY
NO. 4482 WERE TIED IN AND THE CONNECTING
BEARINGS AND DISTANCES VERIFIED.

MONUMENTS FOUND AND USED FOR CONTROL
AND THOSE ESTABLISHED ARE AS SHOWN
ON THE ATTACHED MAP.

DATE: DECEMBER, 1980

FRIAR-MOFFIT & ASSOCIATES
717 WEST 10TH, SUITE 1
MEDFORD, OR 97501
PHONE: 503-772-2782

