


BASIS OF BEARING : SOLAR OBSERVATION
 ● : SET 2" X 30" FLANGED G.I.P. W/ 2 1/2" B.C.
 ○ : FOUND STANDARD B.L.M. MONUMENT
 ⊙ : FOUND 1" G.I.P. W/ POT METAL FILL EXPANDER

SCALE : 1" = 400.0'
METER : m. = 3.2808333 ft.
REF. : FIELDBOOK NO. 1 OF 2 GREEN ACRES CADASTRAL SURVEY CONTRACT NO. 53-04HI-0-8139 N
DATE : SURVEY BEGAN December 27, 1980
 COMPLETED January 16, 1981

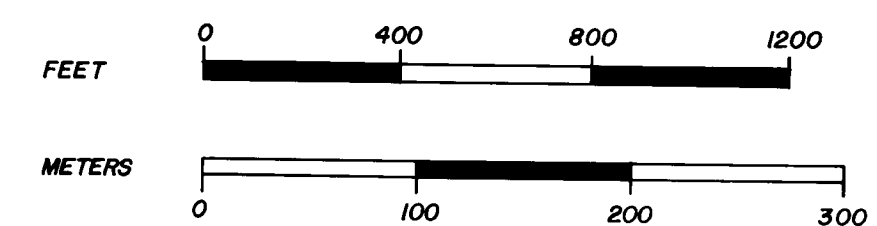

PROCEDURE :
 ALL CONTROLLING CORNERS WERE INCORPORATED IN A SERIES OF CLOSED TRAVERSES USING A WILD T-1 THEODOLITE AND AN H.P. 3805 A E.D.M.. THE NORTH AND WEST QUARTER CORNERS WERE SEARCHED FOR EXTENSIVELY PRIOR TO ACCEPTANCE OF THE PROPORTIONATE POSITIONS. OFFSETS WERE COMPUTED TO THE TRUE LINE AND THE LINES WERE MARKED AND POSTED.

HISTORY :
 SECTION 3 WAS ORIGINALLY SURVEYED BY RUFUS S. MOORE IN 1884 UNDER CONTRACT NO. 496. THE NORTH LINE WAS SUBSEQUENTLY RETRACED BY PETER APPLIGATE IN 1891 UNDER CONTRACT NO. 571. APPLIGATE RETURNED DIFFERENT DISTANCE ALONG THIS LINE. THE WEST LINE WAS SURVEYED BY BRICE L. BRANDT IN 1969 REF. FILED SURVEY NO. 4061, DURING WHICH HE SET THE WEST QUARTER CORNER BY PROPORTION.


CONTRACT SURVEYOR'S CERTIFICATE :
 I, KURT C. WEAVER, A REGISTERED PROFESSIONAL LAND SURVEYOR IN THE STATE OF OREGON, HEREBY CERTIFY THAT THIS PLAT AND THE NOTES HEREON, OR ATTACHED, ARE A CORRECT REPRESENTATION OF A SURVEY PERFORMED BY ME OR UNDER MY DIRECTION DURING JANUARY, 1981, AT THE REQUEST OF THE U.S.D.A. FOREST SERVICE, IN ACCORDANCE WITH THE STATUTES OF THE STATE OF OREGON AND WITH THE ARTICLES OF MY CONTRACT.

Kurt C. Weaver
 KURT C. WEAVER
 REGISTERED PROFESSIONAL LAND SURVEYOR
 OREGON LICENSE 1679

REGISTERED PROFESSIONAL LAND SURVEYOR
 OREGON
 JULY 14, 1978
 KURT C. WEAVER
 1679

EXAMINED AND ACCEPTED FOR THE U.S. FOREST SERVICE
 THIS 30th DAY OF January, 1981.

David J. ...

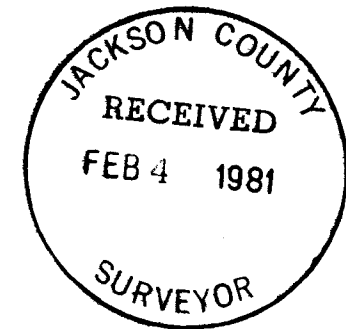

MAP OF SURVEY
 LOCATED IN SECTION 3, T. 32 S., R. 3 E., W. M.,
 JACKSON COUNTY, OREGON

FOR
THE U.S. FOREST SERVICE
 REF. CONTRACT NO. 53-04HI-0-8139 N



Fir snag 36" dia. bears North 8°53' East, 27.3 feet
(record North 10° East, 27.7 feet).

Fir stump 25" dia. bears South 63°13' East, 19.8 feet
(record South 63° East, 19.8 feet).

I mark the following trees, taking measurements to the center of the tree at the lower blaze, in which I place a brass washer stamped LS 1679:

A D. Fir 8" dia. bears North 13°13' East, 93.0 feet.

A W. Fir 9" dia. bears South 22°46' East, 69.6 feet.

1/4 Corner $\frac{34}{3}$: I set a 2 inch x 30 inch flanged G.I.

pipe with a 2-1/2 inch brass cap exposed 6 inches, from which I mark the following bearing trees, taking measurements to the center of the tree at the lower blaze in which I place a brass washer stamped LS 1679:

I. Cedar 9" dia. bears South 61°22' East, 88.5 feet.

P. Pine 10" dia. bears North 35°06' East, 85.0 feet.

A found 1" G.I. pipe with an expander to 2 inches filled with pot metal bears South 81°03'16" East, 7.67 feet.

Section Corner $\frac{34|35}{3|2}$: Found a standard B.L.M. pipe and

brass cap, 1962, exposed 9 inches from which:

D. Fir 8" dia. bears North 15°59' West, 41.3 feet
(record North 18° West, 41.6 feet).

D. Fir 8" dia. bears North 23°54' East, 7.3 feet
(record North 25° East, 6.9 feet).

D. Fir 12" dia. bears South 82°59' East, 11.1 feet
(record South 85° East, 11.9 feet).

Madrone 12" dia. bears South 64°38' West, 10.7 feet
(record South 63° West, 11.2 feet).

Burned Cedar stump bears North 20°24' East, 16.1 feet
(record North 20° East, 15.2 feet).

Dogwood cluster bears South 22°57' West, 8.1 feet
(record South 15° West, 7.3 feet).

The lines shown on the accompanying map were marked with blaze trees and fiberglass posts with "Forest Boundary signs".

Bearing was based on a solar observation.

Surveyed By: T. Flatebo and Associates, Inc.
P.O. Box 900
Jacksonville, OR 97530

Date: Survey began December 29, 1980.
Completed January 16, 1981.



SURVEY NARRATIVE TO COMPLY WITH O.R.S. 209.250

Survey For: U. S. Forest Service
 Rogue River National Forest
 P.O. Box 520
 Medford, OR 97501

Location: Located in Section 3, Township 32 South, Range 3 East of the Willamette Meridian, Jackson County, Oregon.

Purpose: The purpose of the survey was to retrace the North and West lines of Section 3. The lines were then to be marked as the National Forest Boundary.

Procedure: The controlling corners were incorporated in a series of closed traverses using a Wild T-1 theodolite and an H-P 3805A E.D.M.. The west quarter corner was found as shown on the accompanying map. An extensive search was made for this corner prior to accepting the proportionate position. The North quarter corner was set via proportionate position based on the 1891 Applegate retracement. A 1 inch galvanized iron pipe with a pot metal filled expander was found near this location. There is no record of this monument, however, it is the same type that was found at the West quarter corner, and typical of Boise Cascade monuments. The North quarter corner was also extensively searched for.

The following corner monuments and accessories were recorded at the corners:

Section Corner $\frac{4|3}{9|10}$: Found a 1 inch G.I. pipe with an expander to 2 inches filled with pot metal C.S. 1954, BLM 1962 exposed 8 inches from which:

- I. Cedar 13" dia. bears North 82°07' West, 122.8 feet (record North 81° West, 122.7 feet).
- I. Cedar 11" dia. bears North 41°09' East, 24.3 feet (record North 41° East, 24.1 feet).
- D. Fir 13" dia. bears North 68°01' West, 105.0 feet (record North 67° West, 106.3 feet).
- Yew 8" dia. bears South 80°20' West, 92.8 feet (record South 81°30' West, 93.0 feet).
- Hemlock 14" dia. bears South 64°42' West, 29.6 feet (record South 63° West, 29.7 feet).
- Hemlock Snag 12" dia. bears North 10°33' West, 31.5 feet (record North 12° West, 31.0 feet).
- Cross on top of rock outcrop bears South 62°32' East, 2.9 feet (record South 63° East, 2.89 feet).

1/4 Corner $4|3$: Found a 1" G.I. pipe with an expander to 2 inches filled with pot metal exposed 8", from which:

- D. Fir 26" dia. bears South 53°22' West, 23.8 feet (record South 56° West, 22.9 feet).
- D. Fir 21" dia. bears North 3°53' East, 35.9 feet (record North 7° East, 34.6 feet).

Section Corner $\frac{33|34}{4|3}$: Found a standard B.L.M. pipe and brass cap 1962, exposed 7 inches, from which:

- D. Fir 16" dia. bears South 73°36' West, 21.7 feet (record South 74° West, 21.8 feet).
- W. Fir 17" dia. bears North 45°58' West, 36.3 feet (record North 45° West, 37.0 feet).
- Fir snag 7" dia. bears South 27°09' East, 30.8 feet (record South 26° East, 31.0 feet).