

Page 3  
 Narrative  
 Boise Cascade Corporation Survey

PROCEDURE (CONT): A 6" fir bears S 13° W 22.6 feet  
 scribed NW 1/16 S23 BT

A 10" oak bears N 07° W 2.7 feet  
 scribed NW 1/16 S23 BT

At the center West one-sixteenth corner  
 of Section 23 I set a one inch pipe,  
 from which:

A 6" oak bears S 06° W 28.1 feet  
 scribed CW 1/16 S23 BT

A 6" madrone bears N 76° W 18.1 feet  
 scribed CW 1/16 S23 BT

At the Southwest one-sixteenth corner  
 of Section 23 I set a one inch pipe,  
 from which:

A 5" fir bears N 30° E 17.0 feet  
 scribed SW 1/16 S23 BT

An 8" madrone bears S 54° E 12.9  
 feet scribed SW 1/16 S23 BT

At the center South one-sixteenth corner  
 of Section 23 I set a one inch pipe,  
 from which:



A 1" pipe set by Ramsey during Survey  
 No. 1702 bears S 20° 42' 49" W  
 2.78 feet

An 8" fir bears N 33° E 8.4 feet,  
 existing scribe scar visible

A 5" madrone bears S 42° E 20.7 feet,  
 existing scribe partially visible.

DATE: February, 1981

FRIAR-MOFFIT & ASSOCIATES  
 717 West 10th, Suite 1  
 Medford, OR 97501  
 Phone: 503-772-2782

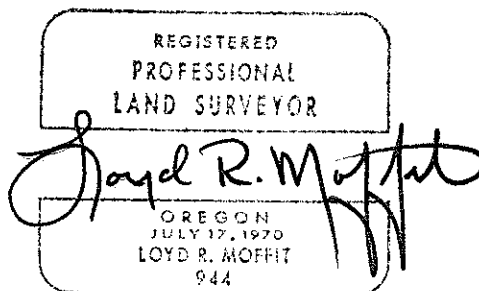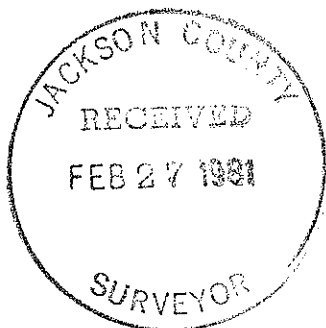

PROCEDURE(CONT):

At the center North one-sixteenth corner of Section 22 I set a one inch pipe, from which:

A 5" madrone bears S 45° E 29.6 feet  
scribed CN 1/16 S22 BT

A 10" fir bears S 56° W 16.9 feet  
scribed CN 1/16 S22 BT

At the East one-sixteenth corner on the North line of Section 22 I set a one inch pipe, from which:

A 12" oak bears S 85° E 46.6 feet  
scribed E 1/16 S22 BT

An existing 3" oak bears S 10° W  
17.2 feet scribed E 1/16 S22 RS 281 BT

A ½" pin bears S 89° 46' 12" W 42.18  
feet

At the center East one-sixteenth corner of Section 22 I set a one inch pipe, from which:

A 12" fir bears N 31° E 15.7 feet  
scribed CE 1/16 S22 BT

A 5" fir bears S 54° E 20.8 feet  
scribed CE 1/16 S22 BT

At the one-quarter corner common to Sections 22 and 23, I found a 1½" pipe set by M.C. Ramsey during his Survey No. 1702. No original evidence could be found. I set a one inch pipe for said corner at a proportionate distance from which:

Ramsey's corner bears N 79° 01' 31" W  
2.07 feet

A 16" fir bears N 50° E 33.5 feet,  
existing scribe scar visible

An 8" fir bears N 54° W 17.5 feet,  
existing scribe scar visible

At the North one-sixteenth corner between Sections 22 and 23 I set a one inch pipe, from which:

An 8" fir bears N 72° E 12.5 feet  
scribed N 1/16 S23 BT

A 12" fir bears S 01° W 19.5 feet  
scribed N 1/16 S22 BT

At the Northwest one-sixteenth corner of Section 23 I set a one inch pipe, from which:

Survey No. 8736

SURVEY NARRATIVE TO COMPLY WITH O.R.S. 209.250

SURVEY FOR: Boise Cascade Corporation  
Southern Oregon Region  
P.O. Box 100  
Medford, OR 97501

LOCATION: A portion of Sections 22 and 23, Township 38  
South, Range 2 West, Willamette Meridian,  
Jackson County, Oregon.

PURPOSE: To establish and mark Boise Cascade  
Corporation's property lines as shown  
on the attached map.

PROCEDURE: A traverse was run around the exterior of  
said Sections 22 and 23 using a one second  
theodolite and a Hewlett Packard E.D.M.  
The closure of said traverse was one foot  
in 51,000 feet. Interior traverses were  
run with a combination of a Kern E.D.M.,  
Hewlett Packard E.D.M. and chaining, all  
of which had a closure exceeding one foot  
in 4,500 feet. All property lines were  
marked with a combination of blazed and  
painted trees, and tags stamped BCCPL.  
All corners set during this survey have  
a metal fence post with a sign attached  
set by the corner.

A search was made by this office and the  
County Surveyor's office for the one-  
quarter corner common to Sections 21 and  
22. Nothing was found. Therefore, I  
set a one inch pipe for said corner at  
a proportionate distance, from which:

A 10" fir bears N 34° W 17.6 feet  
scribed  $\frac{1}{4}$  S21 BT

A 10" fir bears S 68° E 29.7 feet  
scribed  $\frac{1}{4}$  S22 BT

At the center West one-sixteenth corner  
of Section 22 I set a one inch pipe, from  
which:

A 6" madrone bears N 09° E 16.0 feet  
scribed CW 1/16 S22 BT

A 36" oak bears S 37° W 48.3 feet  
scribed CW 1/16 S22 BT

At the Northwest one-sixteenth corner of  
Section 22 I set a one inch pipe, from  
which:

A 10" fir bears S 24° E 17.6 feet  
scribed NW 1/16 S22 BT

A 12" madrone bears N 86° W 9.0 feet  
scribed NW 1/16 S22 BT