## MAP OF SURVEY LOCATED IN THE NEVA OF THE NWVA OF SEC. 18,T39S.,R.2W.W.M., JACKSON CO., OREGON

FOR LARRY HOSKINS

BASIS OF BEARING: SURVEY NO. 8386

FOUND: O JACKSON CO. BRASS CAP


O G.I.P. W/2 I/2"BRASS CAP

● 5/8"X30" I.PIN "/YELLOW

CAP MARKED L.S. 1679

SCALE: 1"= 500 FT. DATE: FEB. 25, 1981.



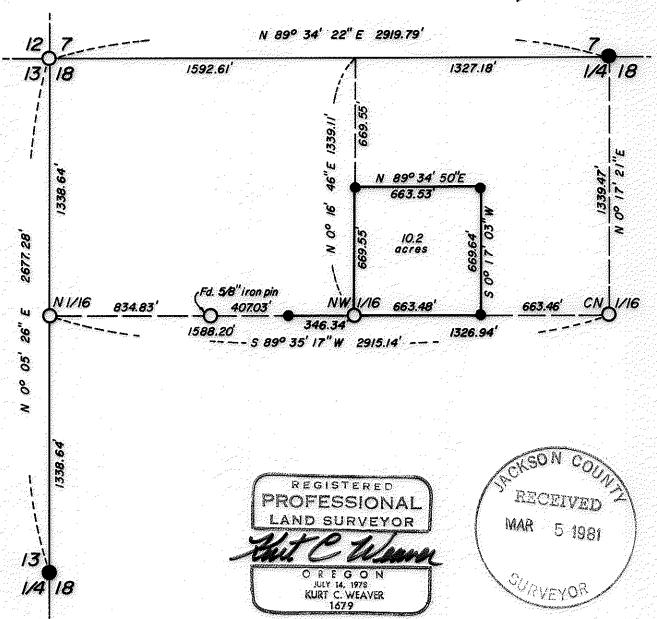

(TL 300 & 404) 39 2W 18

00 7 80

LICEIVED

CHEVEYOR

5 1981

MAR

SURVEY NARRATIVE TO COMPLY WITH O.R.S. 209.250

Mr. Larry Hoskins P10. Box 1049 Survey For:

Jacksonville, OR 97530

Located in the Northwest quarter of Section 18, Township 39 South, Range 2 West of the Willamette Meridian, Jackson County, Oregon. Location:

Purpose: To monument the Southwest quarter of the Northeast

quarter of the Northwest quarter of said Section 18.

Procedure: Utilizing control from filed Survey No. 8386 I

set the 1/64 corners and the monument on the South line of the Northwest quarter of the Northwest quarter. This latter monument is not a property corner, it was set only to physically identify said South line.

Bearing was based on filed Survey No. 8386.

T. Flatebo and Associates, Inc. P.O. Box 900 Jacksonville, OR 97530 Surveyed By:

Date: February 25, 1981

> REGISTERED PROFESSIONAL LAND SURVEYOR

> > O R E G O N SULY 14, 1978 KURT C. WEAVER 1679

(TL 300 & 404) 39 2W 18