


MAP OF SURVEY
FOR
ERNEST PETERSON
LOCATED IN
SEC. 20, T. 37 S., R. 2 W., W. M.
JACKSON CO., OREGON
MARCH 7, 1981

LEGEND
● FOUND 5/8" DIA. IRON PIN
○ SET 5/8" DIA. X 24" LG. IRON PIN
◎ D.L.C. MONUMENT
SCALE 1" = 100'
BASIS OF BEARING - R.S. 7929

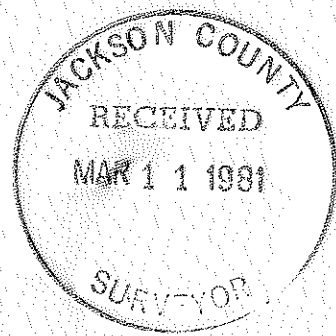

Harold L. Center



SURVEYED BY
HAROLD L. CENTER P.L.S.
MEDFORD, OREGON

Survey No. 1 8745

SURVEY NARRATIVE TO COMPLY WITH
PARAGRAPH 209.250 OREGON REVISED STATUTES

SURVEY FOR: Mr Ernest Peterson
515 Fairmont
Medford, Oregon 97501

LOCATION: Parcel situated within Section 20, Township 37 South,
Range 2 West, Willamette Meridian, Jackson County, Oregon

BASIS OF BEARING: Record survey no. 7929

PURPOSE: To monument the north line of the parcel of land
described in volume 262 page 196 official records,
Jackson county.

HAROLD L. CENTER
Registered Professional Land Surveyor
Oregon Certificate No. 1071

