

# MAP

SHOWING A SURVEY IN THE  
 E 1/2 AND THE NE 1/4, SW 1/4  
 OF SEC. 33, T. 33 S., R. 2 W.,  
 W. M., JACKSON CO., OREGON  
 FEBRUARY 3, 1981  
 SCALE: 1" = 200'

SURVEYED FOR:  
 MARK & TRACY ADAMS  
 4290-C FOOTHILL BLVD.  
 GRANTS PASS, OREGON  
 AND  
 BRETT & VICKIE FARISS  
 932 MOUNT PITT  
 MEDFORD, OREGON

SURVEYED BY:  
 MAX H. HULL, SURVEYING  
 231 NW "B" STREET  
 GRANTS PASS, OREGON

REGISTERED  
 PROFESSIONAL  
 LAND SURVEYOR  
 OREGON  
 JULY 11, 1969  
 MAX H. HULL  
 901

JACKSON COUNTY  

8747

Office 476-2425



**MAX H. HULL Land Surveying**

231 N. W. 'B' Street Grants Pass, Oregon 97526

SURVEY NARRATIVE - Adams/Fariss - Page 2



Thence I traversed North  $89^{\circ}20'45''$  West 5170.22 feet to the West 1/4 corner, at which point I set a 5/8" iron rod from the original bearing trees:

A Yellow Pine 22" in diameter, down and dead, with scribing  
North  $70^{\circ}$  East 20 links

A Yellow Pine stump, North  $18^{\circ}45'$  West 70 links

I also made ties to the Northwest section corner, the Southwest section corner, the East 1/4 corner of Section 28 and the North 1/4 corner of Section 34 to aid in the search for the above described Government corners; thence I traversed East Evans Creek Road as shown on the map and the centerline of East Evans Creek; thence I computed the subdivision of the section as shown on the map and set corners as shown; thence I surveyed the three parcels of land in accordance with their record deed descriptions.

Meridian is based on the West line of the Section per the record G.L.O. Notes.

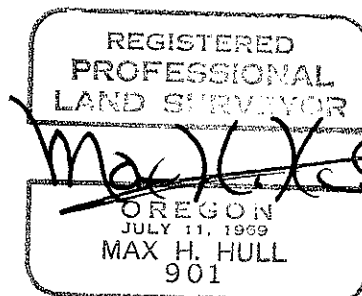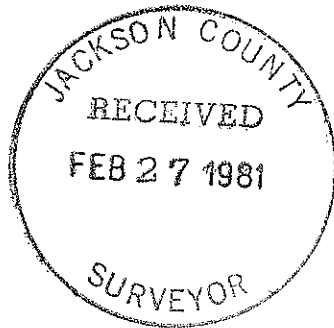

8747

Office 476-2425



**MAX H. HULL Land Surveying**

**231 N. W. 'B' Street Grants Pass, Oregon 97526**

SURVEY NARRATIVE to comply with Paragraph 209.250, O.R.S.

DATE: February 12, 1981

FOR: Mark E. & Tracy L. Adams and Brett A. & Vickie L. Fariss  
4290-C Foothill Blvd. 932 Mount Pitt  
Grants Pass, Oregon Medford, Oregon

PURPOSE: To survey three parcels of land located in Section 33, Township 33 South, Range 2 West, Willamette Meridian, Jackson County, Oregon.

PROCEDURE: Beginning at the Southeast corner of Section 33, at which point I found a brass cap, from which I found:

A Black Oak 7" in diameter, North  $64^{\circ}$  East 23.48 feet  
A Fir 11" in diameter, South  $69^{\circ}$  East 45.50 feet  
A White Oak 13" in diameter, South  $22^{\circ}$  West 60.53 feet  
A Cedar 20" in diameter, North  $54-1/2^{\circ}$  West 61.02 feet

Thence I traversed North  $88^{\circ}32'39''$  West 2673.54 feet to the South  $1/4$  corner, at which point I found a 1963 B.L.M. brass cap from which I found:

A Fir 14" in diameter, North  $10-1/2^{\circ}$  East 85.5 links  
A Fir 12" in diameter, South  $64-1/2^{\circ}$  West 66 links

Thence I traversed North  $0^{\circ}44'15''$  West 5269.19 feet to the North  $1/4$  corner at which point I found the original bearing trees with scribing visible:

A White Oak 36" in diameter, North  $70^{\circ}$  East 26 links  
A White Oak 24" in diameter, South  $45^{\circ}$  West 48 links

Thence I traversed South  $88^{\circ}06'01''$  East 2834.96 feet to the Northeast section corner, at which point I set a  $5/8''$  iron rod from the original bearing trees:

A White Oak 8" in diameter, dead/scribe visible, South  $37^{\circ}$  East 44 links  
A Black Oak (record White Oak) 22" in diameter with scribe North  $30^{\circ}$  East 25 links  
A Yellow Pine stump (decayed) North  $45^{\circ}$  West 43 links

Thence I traversed South  $5^{\circ}04'30''$  West 2563.10 feet to the East  $1/4$  corner, at which point I set a  $5/8''$  iron rod from the original bearing trees:

An Ash 20" in diameter with scribe, South  $40^{\circ}$  East 40 links  
A Yellow Pine snag, South  $10^{\circ}30'$  West 53 links