


BASIS OF BEARINGS:  
RS 4777

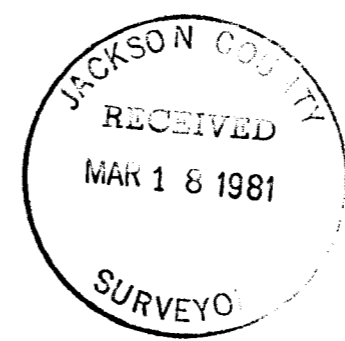

SURVEY FOR: DAVE OLSEN		81-10
LOCATION: SW 1/4 SEC. 2, T. 35S, R. 4W, W.M. JACKSON COUNTY, OREGON		
DATE: MARCH 17, 1981	<div style="border: 1px solid black; padding: 5px; text-align: center;"> REGISTERED PROFESSIONAL LAND SURVEYOR </div>	
SCALE: 1" = 200'		
MONUMENT FOUND	<i>Darrel W. Edwards</i>	
5/8"x30" STEEL PIN SET	<div style="border: 1px solid black; padding: 5px; text-align: center;"> OREGON JULY 8, 1966 DARREL W. EDWARDS 741 </div>	
RECORD MEASUREMENT		

SURVEY NO 8753

SURVEY NARRATIVE TO COMPLY WITH PARAGRAPH 209-250, OREGON REVISED STATUTES

SURVEY FOR: Dave Olsen  
520 Schiefflein Gulch  
Gold Hill, Oregon

LOCATION: SW 1/4 Sec. 2, T.35S., R.4W., W.M., in Jackson County, Oregon.

PURPOSE: To locate and monument the West line of the Olsen property  
as shown on the accompanying plat.


PROCEDURE: I found the Section Monuments as shown on the accompanying plat.  
Using said monuments I set the Southwest corners of the N 1/2,  
and the S 1/2 of the NW 1/4 of the SW 1/4 of Section 2.

EQUIPMENT: Zeiss Th 43 Theodolite and Lietz Red-1 EDM.

BASIS OF BEARINGS: RS 4777

DATE COMPLETED: March 17, 1981

Darrel W. Edwards  
P.O. Box 801  
Rogue River, Oregon 97537  
Ph. 582-3110

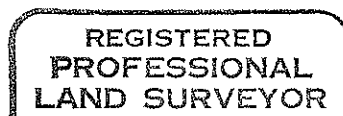

*Darrel W. Edwards*

