

5928

Survey for BOB BILLS

Located in

SW 1/4, Sec. 8, T.37S., R.1W., W.M.,
Jackson County, Oregon

Feb. 25, 1981

REGISTERED
PROFESSIONAL
LAND SURVEYOR

Verlyn Thomas

OREGON
VERLYN D. THOMAS



BASIS OF BEARINGS:
Survey No. 3590

LEGEND

- Mon. found
- 5/8" x 24" iron pin set unless otherwise noted

7
8
1/4 Cor.
Brass cap

Survey No. 3590

Fd. 5/8" pin

S89°55'11"E
277.17'

Fd. 5/8" pin

N0°05'10"W
252.17'

Crater Lake Avenue

N0°05'10"W

S89°54'50"E
59.95'

Set PK nail
in concrete

S0°05'10"E
432.20'

Countrywood Sub. No. 1

N89°54'50"W
277.17'

Fd. 5/8" pin

S0°05'10"E
170.00'

Survey No. 5160

Delta Waters Sub.

593.00'

59.95'

Set lead
plug & tack

S89°54'50"E

Delta Waters Road

Blackthorn Drive
Brass cap in concrete

7
8
18
17
Sec. Cor.
Bolt in mon. case

9928

Survey by Verlyn Thomas, Professional Land Surveyor, Medford, Oregon

(TL 1400 & 1500) 37 1W BCC

SURVEY NO. 8766


SURVEY NARRATIVE TO COMPLY WITH O.R.S. 209.250

For: Bob Bills
406 S. Riverside Avenue
Medford, Oregon 97501

Purpose: To survey and monument a parcel according to legal descriptions
furnished by client.

Procedure: Recovered monuments established by previous surveys, and set
additional monuments as shown on the accompanying plat.

Basis of Bearings: Survey No. 3590

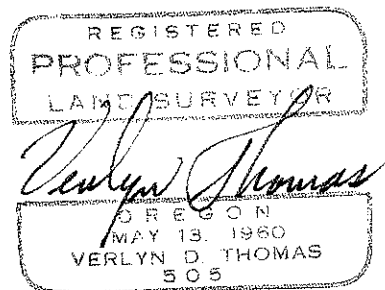

Verlyn Thomas,
Professional Land Surveyor
304 S. Holly
Medford, Oregon 97501
773-8866

37-1W-8 CC