

SURVEY NARRATIVE & PLAT TO COMPLY WITH PARAGRAPH 209.250
OREGON REVISED STATUTES


8799

Survey for: John B. Wells, Jr.
2895 Mel-Lowe Lane
Medford, Oregon 97501

Purpose : To monument these corners shown in accordance with the description furnished by the client.

Procedure : Utilization of survey control previously established during the course of Surveys No. 2485 and 8427.

Survey in D.L.C. 49 and Gov't. Lot 7
of Section 13, T. 38 S., R. 2 W., W.M.,
Jackson County, Oregon.

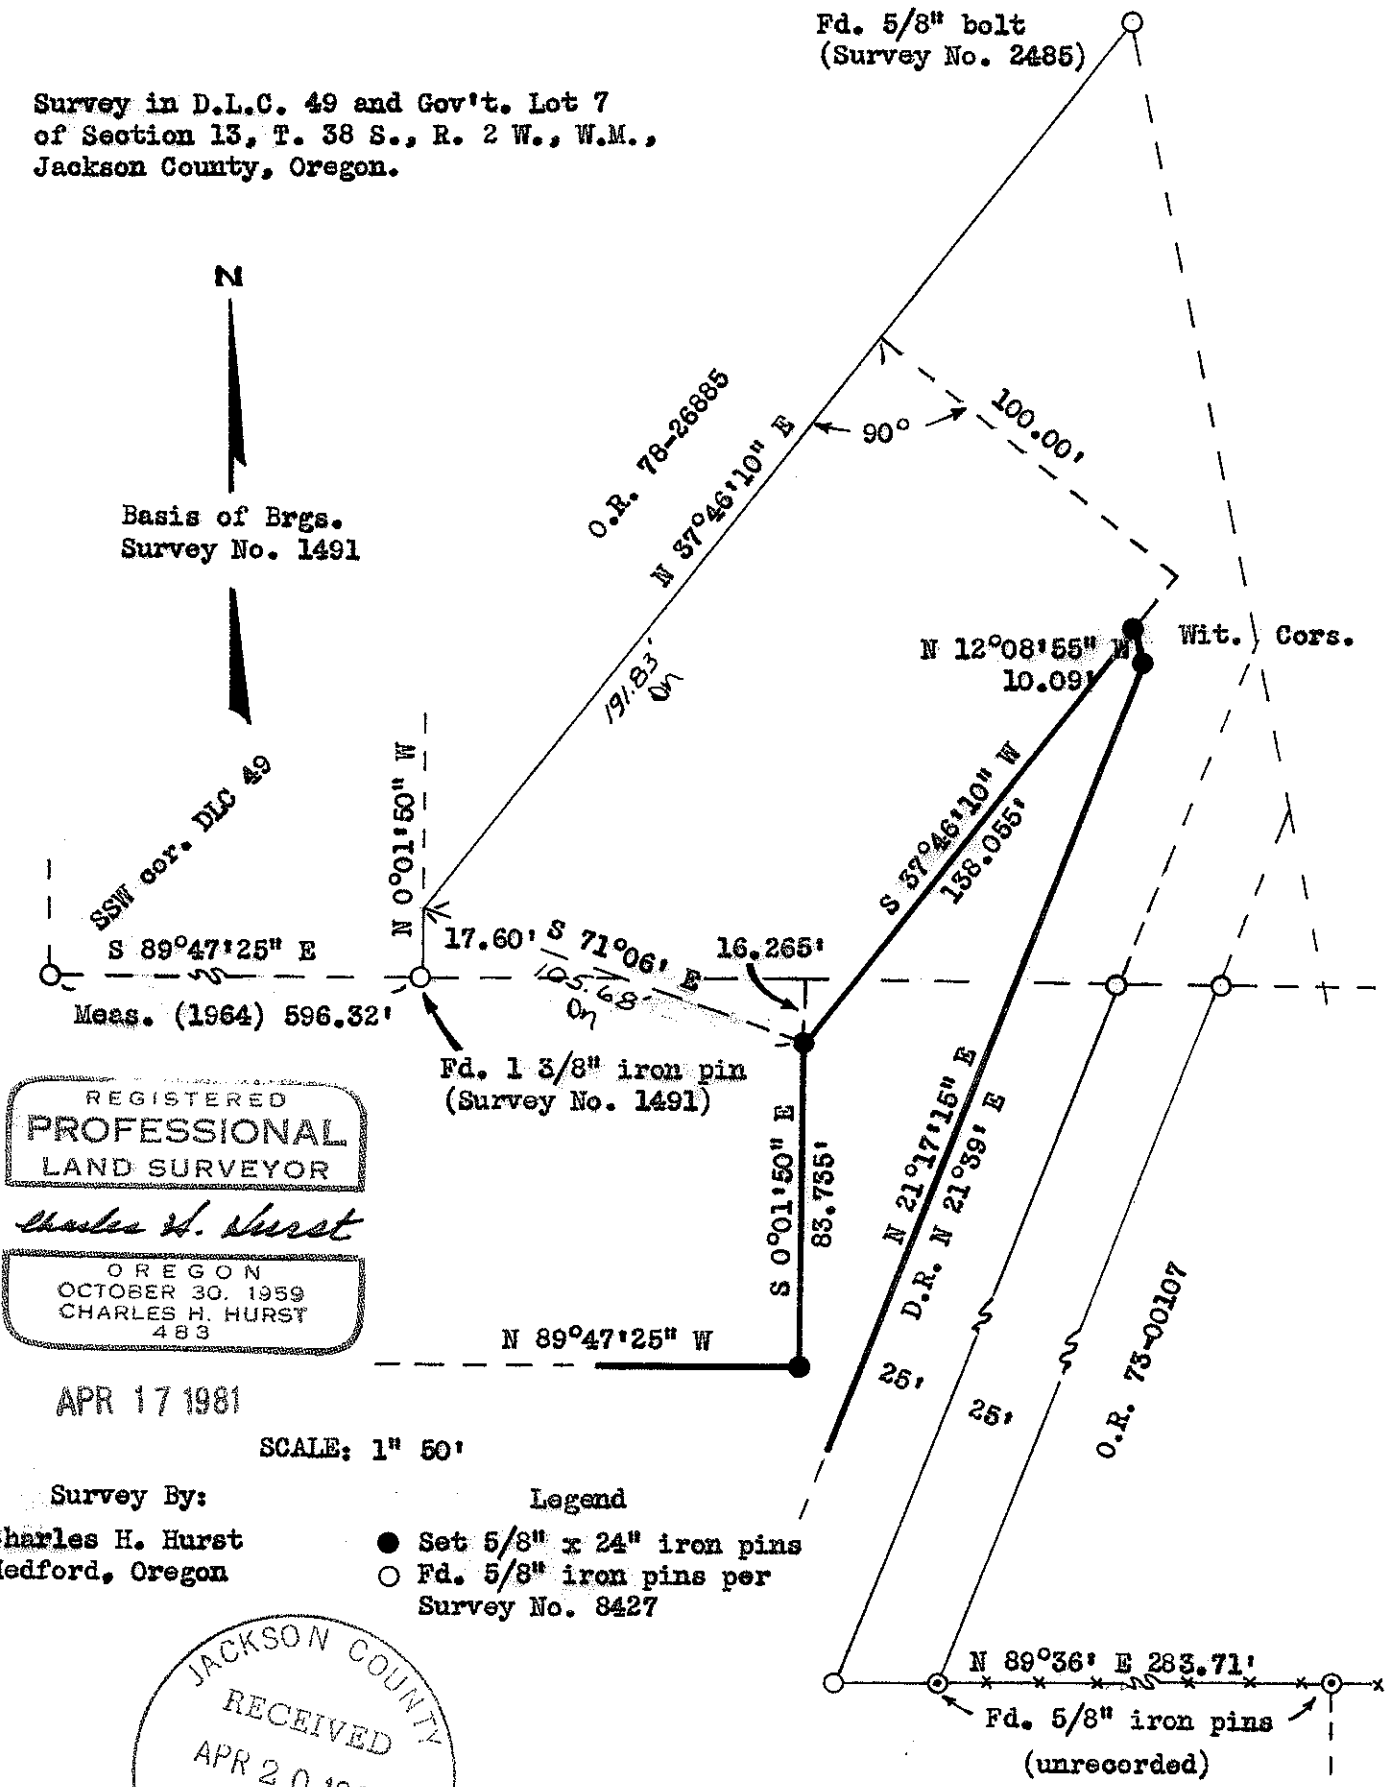

REGISTERED
PROFESSIONAL
LAND SURVEYOR
Charles H. Hurst
OREGON
OCTOBER 30, 1959
CHARLES H. HURST
483

APR 17 1981

SCALE: 1" = 50'

Survey By:
Charles H. Hurst
Medford, Oregon

- Legend
- Set 5/8" x 24" iron pins
 - Fd. 5/8" iron pins per Survey No. 8427

JACKSON COUNTY
RECEIVED
APR 20 1981
SURVEYOR

8799

38 2W 13