



**MAX H. HULL Land Surveying****231 N. W. 'B' Street Grants Pass, Oregon 97526**

SURVEY NARRATIVE to comply with Paragraph 209.250, O.R.S.



DATE: April 21, 1981

FOR: Ralph Bryant  
19711 East Evans Creek Rd.  
Central Point, ORPURPOSE: To survey the South line of the Northeast 1/4, Southwest 1/4 of  
Section 33, Township 33 South, Range 2 West, Willamette Meridian,  
Jackson County, Oregon.PROCEDURE: Using Survey No. 8747, and field control established during  
said survey, including the tie made to the Southwest section  
corner, at which point I found a B.L.M. brass cap, from which  
I found:

A Yellow Pine 20" in diameter, North  $24-1/2^{\circ}$  East 67 links  
 An Oak 10" in diameter, South  $84^{\circ}$  East 10 links  
 A Yellow Pine 30" in diameter, South  $47-1/2^{\circ}$  West 59 links  
 An Oak 24" in diameter, North  $34-1/2^{\circ}$  West 149 links

Thence I computed the subdivision of the Southwest 1/4 and set  
 the Southwest 1/16 corner as shown on the map; thence I surveyed  
 and marked true line between said Southwest 1/16 corner and the  
 Center South 1/16 corner South  $88^{\circ}43'01''$  East 1311.11 feet.

Meridian is based on Survey No. 8747.

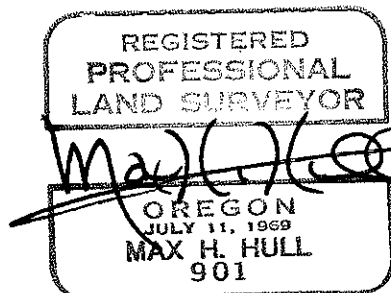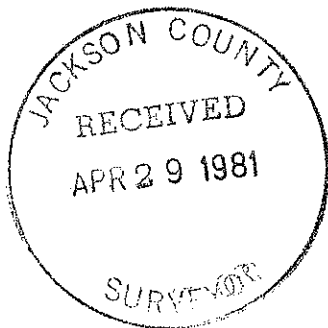

33 2W 33

37 2W 25 DA