

CERTIFIED RECORD OF LAND CORNER MONUMENTATION

History of original corner establishment:

Corner: Common Cor. 15,16,21 & 22

Twp. 40S R. 4E


Original Survey By: E. T. T. Fisher

Contract Number: 77

Contract Date: 2-1-1858

Original Description:

Set post in a mound of rock on an open side hill facing S.W., for corner to Secs. 15,16,21 & 22. No witness trees.

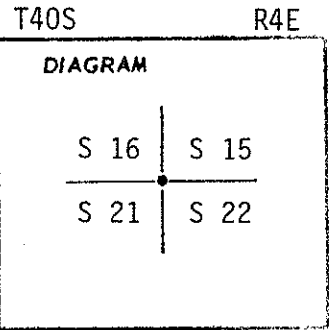


Description of corner evidence found:

- A rock mound with 3/4" Cu-Ni pipe and 3' oak post squared at top foot.
- a 4" oak, bears N73⁰W, 52.1 lks. dist.
- a 4" oak, bears S23⁰W, 53.6 lks. dist. dead-standing
- a 4" oak, bears N61⁰E, 78.7 lks. dist.
- a 18" p. pine bears S65⁰E, 277.2 lks. dist

Set by ORLS 0317 in 1958

Description of monument and accessories established to perpetuate the original location of this corner

- Set a 2 1/2" iron pipe over Cu-Ni pipe with a 2 1/2" brass cap in a 3' x 1 1/2' mound of stone from which:
- a 4" oak, bears N16⁰W, 67.4 ft. distance. Placed tag, "W" nail and scribed T40S R4E S16 BT.
- a 5" oak bears N58⁰E, 51.3 ft. distance. Placed tag, "W" nail and scribed T40S R4E S15 BT.
- a 6" oak, bears S60⁰E, 72.8 ft. distance. Placed "W" nail and tag, scribed T40S R4E S22 BT.
- a 5" oak, bears S28⁰W, 34.6 ft. distance, placed "W" nail and tag, scribed T40S R4E S21 BT.
- a 3" oak bears N23⁰E, 33.9 ft. distance reference tree. Original BT

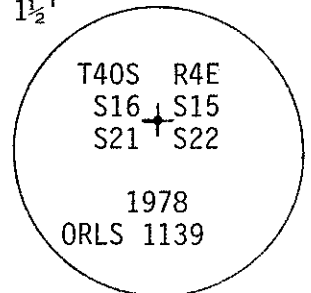

REGISTERED
PROFESSIONAL
LAND SURVEYOR

Dennis L. Brandt

OREGON
SEPT. 23, 1977
DENNIS L. BRANDT
1139

Office of County of

State of, I hereby certify that the within instrument was filed in this office for record on the day of

..... by
(COUNTY OFFICIAL) (DEPUTY)

JACKSON COUNTY
RECEIVED
MAY 7 1981
SURVEYOR