



LEGEND:
 ● - FOUND 3/4" IRON PIN IN MONUMENT WELL.
 ○ - FOUND 5/8" IRON PIN
 ○ - SET 5/8" IRON PIN WITH PLASTIC CAP STAMPED, MOFFIT PLS 944.

BASIS OF BEARINGS:
 SURVEY NUMBER 5429

PLAT OF SURVEY
 FOR
**HOUSING AUTHORITY
 OF
 JACKSON COUNTY**

BEING A PORTION OF BLOCK 51 OF THE ORIGINAL TOWN OF MEDFORD, ALSO BEING A PORTION OF THE S.W. 1/4 OF SECTION 30, TOWNSHIP 37 SOUTH, RANGE 1 WEST, WILLAMETTE MERIDIAN. JACKSON CO. OREGON. SCALE: 1"=10'

DATE: MAY, 1981
 PREPARED BY: FRIAR-MOFFIT AND ASSOC. MEDFORD, OREGON

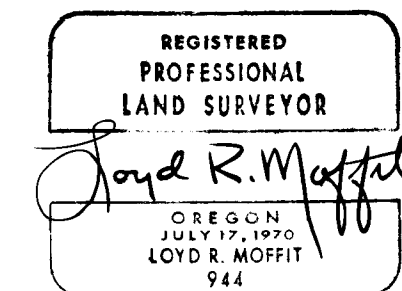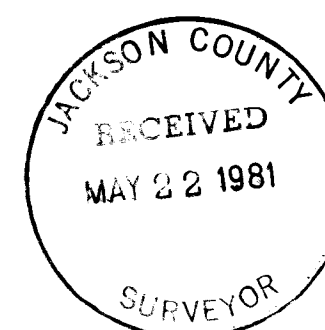

SURVEY NO. 8844

SURVEY NARRATIVE TO COMPLY WITH O.R.S. 209.250

SURVEY FOR: Housing Authority of Jackson County
239 Beatty Street
Medford, OR 97501

LOCATION: A portion of Lot 9 and all of Lots 10, 11 and 12 of Block 51 of the Original Town of Medford, also a portion of the Southwest one-quarter (1/4) of Section 30, Township 37 South, Range 1 West, Willamette Meridian Jackson County, Oregon.

PURPOSE: To survey and monument the client's property.

PROCEDURE: Found monuments as shown at the various street intersections. Set corners at proportionate distances as shown.

DATE: May, 1981

FRIAR-MOFFIT & ASSOCIATES
717 West 10th, Suite 1
Medford, OR 97501
Phone: 772-2782

