

(Basis of Bearing per Survey No. 564)
 N 89° 58' 15" E 1004.39' (Survey No. 1874 = 1004.23')

**COTTAGE HOME
 ADDITION**

SURVEY NO. 994

SURVEY NO. 1229

S.E. Cor. D.L.C. No. 42
 Fd. 5/8" Iron Pin
 in mon. case

SURVEY NO. 2060

MAP OF SURVEY
 LOCATED IN
 JACKSON ADDITION
 COTTAGE HOME ADDITION
 N.E. 1/4 of SEC. 30, T.37S., R.1W., W.M.
 JACKSON COUNTY, OREGON
 FOR

JOEL P. SLAUGHTER D.M.D.
 HOFFBUHR / BATH & ASSOCIATES, INC.
 MEDFORD, OREGON

BY: RICHARD L. BATH R.P.L.S. NO. 1069
 SCALE 1" = 50' APRIL 30, 1981
 BASIS OF BEARING SURVEY NO. 564

- = Fd. 5/8" Iron Pin
- ⊙ = Fd. Lead Plug & Tack
- = Set 5/8" x 24" Iron Pin
tagged "R. BATH L.S. 1069"

JACKSON COUNTY
 RECEIVED
 JUN 4 1981
 SURVEYOR

REGISTERED
**PROFESSIONAL
 LAND SURVEYOR**
Richard L. Bath
 OREGON
 JULY 30, 1976
 RICHARD L. BATH
 No. 1069

Fd. 5/8" Iron Pin
 1" deep per
 Survey No. 5259

Fd. Nail reported
 per Survey No.
 1874

S 89° 57' 19" W 622.19'
SURVEY NO. 5259

SURVEY NO. 8855

SURVEY NARRATIVE TO COMPLY WITH PARAGRAPH 209.250
OREGON REVISED STATUTES

SURVEY FOR: Joel P. Slaughter, D.M.D.
826 East Main Street
Medford, Oregon 97501



LOCATION: Northeast one-quarter (1/4) of Section 30,
Township 37 South, Range 1 West, Willamette
Meridian, Jackson County, Oregon

PURPOSE: To survey, monument, and describe the tract
as shown on the attached map per client's
request


PROCEDURE: A complete analysis of Survey No. 564, 994, 1331,
1874, 2060, 4749, and 5259 indicated the control necessary to
accomplish the boundary survey. Monuments found, as shown, checked
with their record positions and were used to control the position-
ing of the new monuments. The senior deeds that determined the
location of the West line of the subject tract were Volume 150,
page 41, and Volume 151, page 50, of the Deed Records. The North
line of the subject tract was determined per client's request.

Basis of bearing--Survey No. 564

April 30, 1981

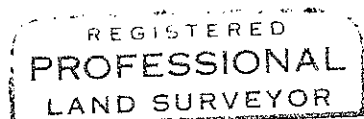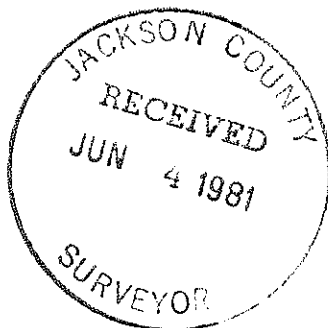

Richard L. Bath

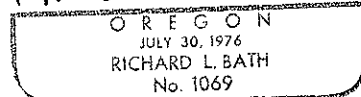

Richard L. Bath
Hoffbuhr Surveying, Inc.
219 North Oakdale
Medford, Oregon 97501