

SURVEY NO. 8850

FD. B.L.M. BRASS CAP
MARKING THE N.W.
CORNER OF SEC. 5

N 89° 01' 13" E 2690.05' (REC. 2690.26')

FD. B.L.M. BRASS CAP
MARKING THE N. 1/4
CORNER OF SEC. 5

N 00° 15' 39" W 2736.62' (REC. 41.04 CH.)

5417.86'



W. 1/4 SEC. 5

1336.15'

N 89° 11' 04" E

5357.60'

FD. 1" PIPE MARKING
THE E. 1/4 CORNER
OF SECTION 5

1336.15'

N 00° 15' 39" W 2667.27' (REC. 40.0 CH.)

1336.65'
S 00° 06' 29" W

LEGEND:

- = FOUND MONUMENT AS SHOWN.
- = SET 5/8" IRON PIN WITH PLASTIC CAP STAMPED, MOFFIT PLS 944.

BASIS OF BEARINGS:

SURVEY NUMBER 8850.

N 89° 14' 49" E

2663.67'

2670.275'

665.92'

FD. B.L.M. BRASS CAP
MARKING THE S.W.
CORNER OF SEC. 5

S 89° 18' 35" W

2655.04' (REC. 39.70 CH.)

FD. CO. BRASS CAP
MARKING THE S. 1/4
CORNER OF SEC. 5

N 00° 00' 57" E 1335.89'

1336.65'


N 00° 04' 34" W

663.76'

REGISTERED
PROFESSIONAL
LAND SURVEYOR

Lloyd R. Moffit

OREGON
JULY 17, 1970
LOYD R. MOFFIT
944

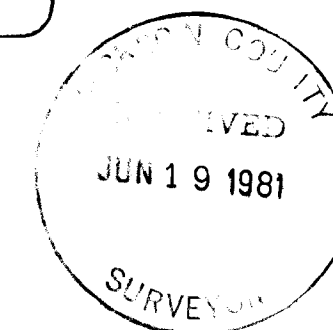

PLAT OF SURVEY
FOR
GAIL WILLEY

BEING THE EAST 1/2 OF THE SOUTHEAST
1/4 OF THE SOUTHWEST 1/4 OF SECTION
5, TOWNSHIP 39 SOUTH, RANGE 2 WEST,
WILLAMETTE MERIDIAN

JACKSON CO. SCALE: 1"=400'
OREGON DATE: JUNE, 1981

PREPARED BY: FRIAR - MOFFIT AND ASSOCIATES
MEDFORD, OREGON

SURVEY NO. 8877

SURVEY NARRATIVE TO COMPLY WITH O.R.S. 209.250

SURVEY FOR: Gail Willey
339½ Oak Grove Road
Medford, OR 97501

LOCATION: The East one-half of the Southeast one-quarter
of the Southwest one-quarter of Section 5,
Township 39 South, Range 2 West, Willamette
Meridian, Jackson County, Oregon.

PURPOSE: To survey and monument the client's property.

PROCEDURE: Ran a traverse to the three quarter corners,
the Northwest corner and the Southwest corner
of Section 5. A search was made for the
West one-quarter corner of Section 5, but
no original evidence could be found. There-
fore the position was determined by propor-
tionate distances. From said corner an
8 inch oak with two blazes bears North
39° West 26.1 feet and a 3 inch pine with
one blaze bears North 40° East 21.5 feet.
Said corner is at the top of a 3 foot cut
bank which was made for a dirt road.

DATE: June, 1981.

FRIAR-MOFFIT & ASSOCIATES
717 West 10th, Suite 1
Medford, OR 97501
Phone: 503-772-2782

