

8922

CRATER LAKE AVE


S.E. CORNER D.L.C. 42 FD. SPIKE 1.13' W EAST MAIN STREET N.E. CORNER D.L.C. 44 FD. BRASS DISC.

FD. 5/8" IRON PIN IN MON. CASE

EAST MAIN STREET

N 89° 59' 50" W 255.22' (REC. WEST 255.38')

178.95' (REC. 179.00')

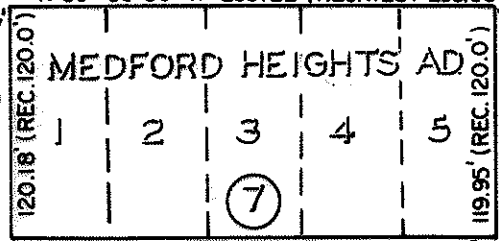

120.18' (REC. 120.0') 119.95' (REC. 120.0')


















FLORENCE AVENUE

EASTWOOD DRIVE

ORIGINAL BLOCK BOUNDARY

SCOTT STREET

MEDFORD HEIGHTS TOWNHOUSES

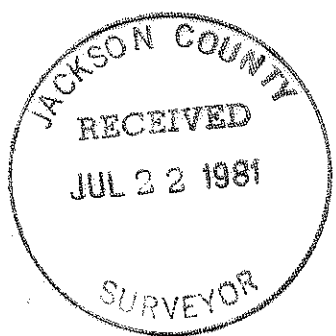

MAP OF SURVEY
 LOCATED IN
 N.E. 1/4 of Sec 30, T37S, R1W, W.M.
 A PORTION OF BLOCK 7 OF
 MEDFORD HEIGHTS ADDITION
 JACKSON COUNTY, OREGON
 FOR

RICHARD BARTLING

HOFFBUHR SURVEYING, INC. MEDFORD, OREGON


SCALE 1" = 100'

JUNE 13, 1981

BASIS OF BEARING

R/S NO. 4666

- = SET LEAD & TACK IN CONCRETE
- = SET 5/8" x 24" IRON PIN
- = BRASS DISC SET IN CONCRETE

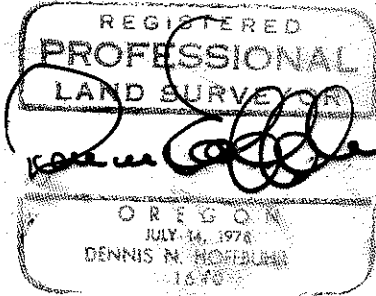

37 1W 30 AD

SURVEY NO. 8922

SURVEY NARRATIVE TO COMPLY WITH PARAGRAPH 209.250
OREGON REVISED STATUTES

SURVEY FOR: Richard Bartling
21 Florence Avenue
Medford, Oregon 97501

LOCATION: Block 7, Medford Heights Addition, Northeast
one-quarter (1/4) of Section 30, Township 37
South, Range 1 West, Willamette Meridian,
Jackson County, Oregon

PURPOSE: Monument the property lines as shown on the
attached map

PROCEDURE: Ran a closed traverse to tie down the existing
monumentation as shown. The alignment of Eastwood Drive was
determined by locating the centerline midway between the curbs.
The boundary of Block 7 was thus determined and the lot lines
computed proportionately.

June 13, 1981

REGISTERED
PROFESSIONAL
LAND SURVEYOR



OREGON
JULY 14, 1978
DENNIS N. HOFFBUHR
1640

Dennis N. Hoffbuhr
Hoffbuhr/Bath & Associates, Inc.
219 North Oakdale
Medford, Oregon 97501

JACKSON COUNTY
RECEIVED
JUL 22 1981
SURVEYOR