

MAP OF SURVEY

LOCATED IN
SECTION 23, T.38S., R.3W., WM.
JACKSON COUNTY, OREGON

FOR
LESTER JACOBSON

HOFFBUHR / BATH & ASSOCIATES, INC.
MEDFORD, OREGON

BY: **ROGER R. ROBERTS** R.P.L.S. NO. 1656
SCALE: 1" = 300' JULY 20, 1981
BASIS OF BEARING SURVEY 3183

REGISTERED
PROFESSIONAL
LAND SURVEYOR

Roger R. Roberts

OREGON
ROGER R. ROBERTS
1656

JACKSON COUNTY
RECEIVED
JUL 24 1981
SURVEYOR

81 - 033

SURVEY NO. 8923

SURVEY NARRATIVE TO COMPLY WITH PARAGRAPH 209.250
OREGON REVISED STATUTES



SURVEY FOR: Lester Jacobson
P.O. Box 6087
Oxnard, California 93030

LOCATION: Section 23, Township 38 South, Range 3 West,
Willamette Meridian, Jackson County, Oregon


PURPOSE: Locate and monument property corner

PROCEDURE: An electronic distance meter traverse was run
between the found monumentation, the property corner location
computed and set midway between the one-sixteen (1/16) corner
and one-quarter (1/4) corner.

July 20, 1981

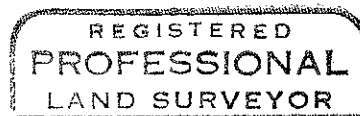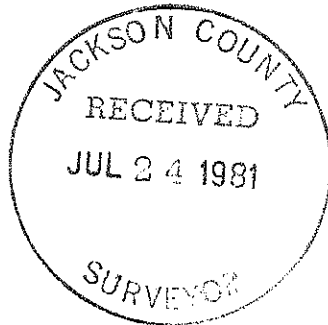

Roger R. Roberts

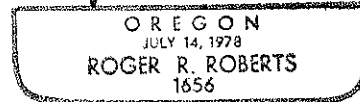

Roger R. Roberts
Hoffbuhr/Bath & Associates, Inc.
219 North Oakdale
Medford, Oregon 97501