

SURVEY FOR: Ernest and Dianna Pritchett	
LOCATION: NW & SW 1/4 Sec. 26, T. 36S., R. 4W., W.M. Jackson County, Oregon.	
DATE: August 21, 1981	REGISTERED PROFESSIONAL LAND SURVEYOR
SCALE: 1"=100'	
• Monument Found	Darrell W. Edwards OREGON JULY 8, 1950 DARREL W. EDWARDS 741
○ 5/8" x 30" Steel Pin Set	
() Record Distance	
*** Fence Line	

36 4x 26

SURVEY NO. 8990

SURVEY NARRATIVE TO COMPLY WITH PARAGRAPH 209.250, OREGON REVISED STATUTES

SURVEY FOR: Ernest and Dianna Fritchett
3855 North River Road
Gold Hill, OR 97525

LOCATION: NW and SW 1/4 of Section 26, Township 36 South, Range 4 West
of the Willamette Meridian, Jackson County, Oregon.

PURPOSE: To locate and monument that portion of the Northeasterly right
of way line of the Southern Pacific Railroad forming the South-
westerly boundary of the Fritchett property as shown on the
accompanying plat and described in Official Records.


PROCEDURE: Found Brass Cap set by the County Surveyor for the West 1/4
corner of Section 26. Also found a two inch Iron Pipe at the
initial point of block "A" of Jowood Park Estates and two
5/8 inch steel pins on the East line of the Southwest 1/4 of
of the Northwest 1/4 of Section 26 as per R. S. 3599. Set
5/8" x 30" steel pins as shown on the accompanying plat.

EQUIPMENT: Lietz TM 20C Theodolite and Lietz Red 1 EDM.

BASIS OF
REFERENCES: R.S. 8671

DATE COMPLETED: August 21, 1981

Darrel W. Edwards
P. O. Box 801
Rogue River, OR 97537
Telephone 582-3110

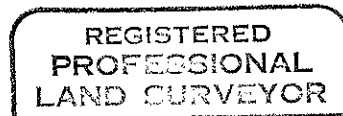

Darrel W. Edwards

