
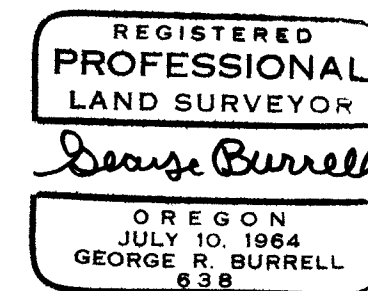
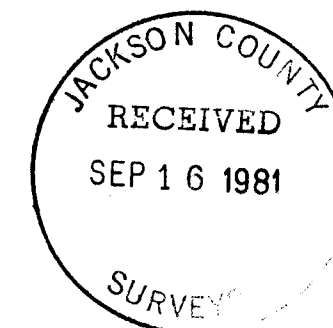


SCALE 1" = 300'

Basis of Bearings R.S.No. 6937

LEGEND

- = Set 5/8" x 2 1/4" I. Pin (tagged R.L.S638)
- = Found mon. as noted
- ⊙ = Fd. B.L.M 2" br. capped pipe and B.T.s (unless noted otherwise)
- = Lines marked with 4' steel fence posts

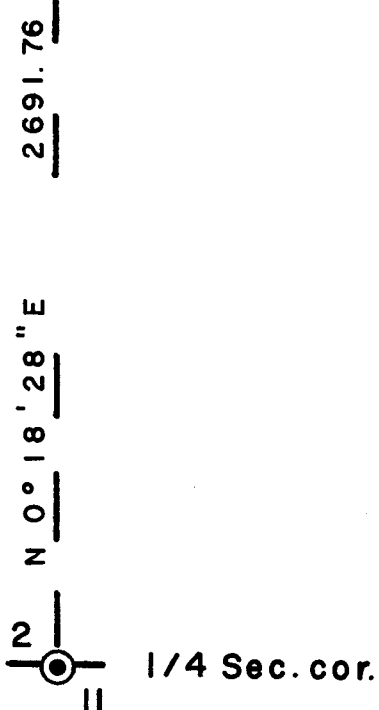

MAP OF SURVEY

Located in Section 2 Twp 39S, R 2E  
 For: JIM MILLER  
 By: Geo. Burrell, Surveyor 8/14/81  
 9/2/81

SURVEY NO. 9001

SURVEY NARRATIVE TO COMPLY WITH O.R.S. 209.250

FOR: Jim Miller  
975 Dead Indian Rd.  
Ashland, Oregon

PURPOSE: To monument the corners and mark the lines of the clients  
ownership in Section 2, T 39 S, R 2 E.

PROCEDURE: Utilizing a Franke 20" theodolite and a H.P. 3805  
distance meter, the exterior corners of sectional  
control were traversed to, from which the interior  
subdivisional section lines were calculated and established  
as shown on the accompanying map.  
The lines between corner monuments were marked with 5'  
high steel fence posts, except for the East line of the  
N.W. 1/4 of the N.W. 1/4 which was not run.

BY: George Burrell, Surveyor  
1379 Brookdale  
Medford, Oregon                      Sept. 2, 1981

