

JACKSON COUNTY
RECEIVED
SEP 25 1981
SURVEYOR

SURVEY FOR: S. P. Arnold	
LOCATION: NE 1/4 Sec. 5, T. 35S., R. 3W., W.M. Jackson County, Oregon.	
DATE: August 18, 1981	<p>REGISTERED PROFESSIONAL LAND SURVEYOR</p> <p><i>Darrel W. Edwards</i></p> <p>OREGON JULY 8, 1960 DARREL W. EDWARDS 741</p>
SCALE: 1"=100'	
● Monument Found	
○ 5/8"x30" Steel Pin Set	
() Record Distance	

(TL 905) 35 3W 5

SURVEY NO. 9010

SURVEY NARRATIVE TO COMPLY WITH PARAGRAPH 209.250, OREGON REVISED STATUTES

SURVEY FOR: S. P. Arnold
16320 E. Evans Creek Rd.
Rogue River, OR 97537

LOCATION: Northeast quarter of Section 5, Township 35 South, Range 3 West of the Willamette Meridian.

PURPOSE: To locate and monument property boundaries of a 5.03 acre tract.



PROCEDURE: I found the monuments as show. Using said monuments and deed records I set 5/8 inch by 30 inch steel pins at the corners of the Arnold property as shown on the accompanying plat.

EQUIPMENT: Lietz TM 200 Theodolite and Lietz Red-1 EDM.

BASIS OF
BEARINGS: R. S. 5082

DATE COMPLETED: August 18, 1981

Darrel W. Edwards
P. O. Box 801
Rogue River, OR 97537
Telephone 582-3110

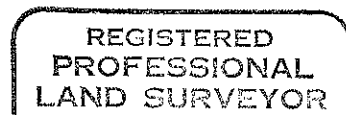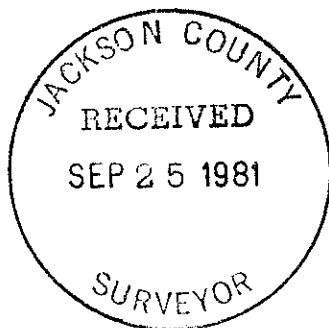

Darrel W. Edwards

