

81-19274


81-19274

81-19274

CEDAR HILLS-UNIT No.3

Located in the N.E. 1/4 Sec. 17, T.37S., R.1W., W.M., City of Medford,
Jackson County, Oregon

POST MONUMENTATION PLAT

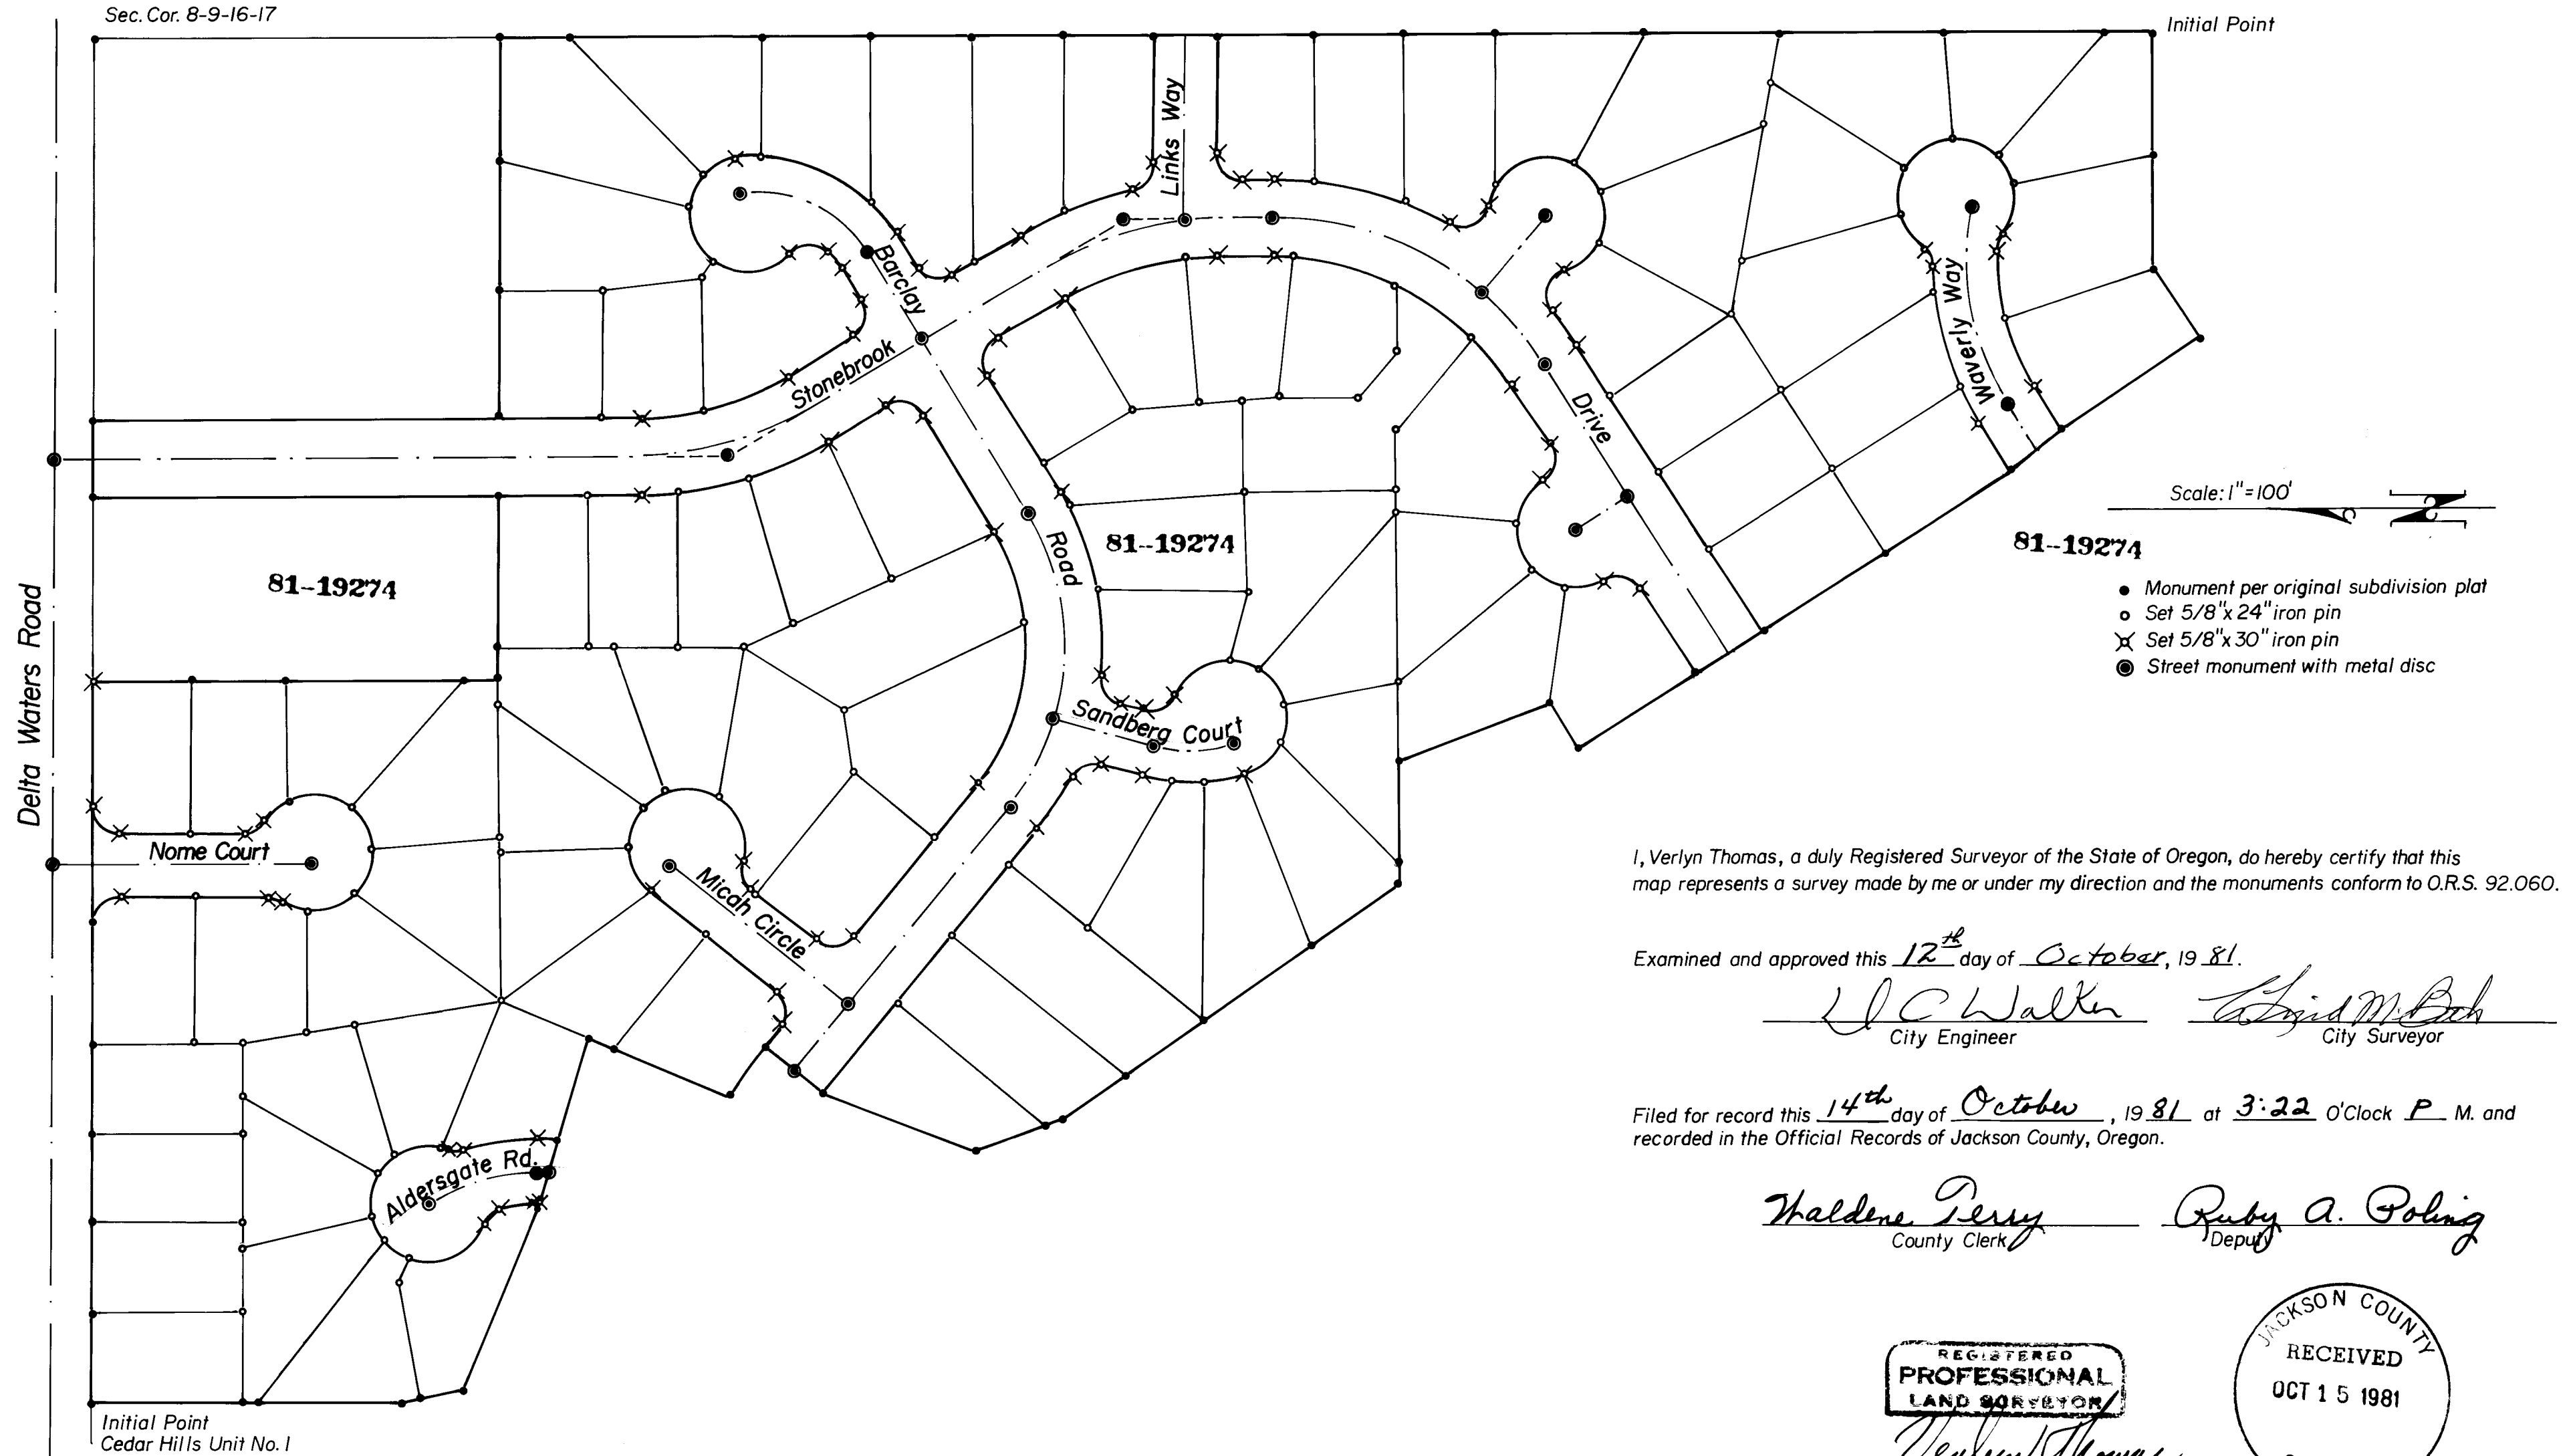

I, Verlyn Thomas, a duly Registered Surveyor of the State of Oregon, do hereby certify that this map represents a survey made by me or under my direction and the monuments conform to O.R.S. 92.060.

Examined and approved this 12th day of October, 19 81.

J. C. Walker City Engineer Clifford M. Bach City Surveyor

Filed for record this 14th day of October, 19 81 at 3:22 O'Clock P. M. and recorded in the Official Records of Jackson County, Oregon.

Waldene Perry County Clerk Ruby A. Poling Deputy

