

MINOR LAND PARTITION
LOCATED IN THE S.W. 1/4 OF SECTION NO. 3,
T. 39 S., R. 3 W., W.M. JACKSON CO., OREGON.

FOR
MICHAEL AND GERALDINE BONNER


BASIS OF BEARING: SURVEY NO. 8046
FOUND: ○ 5/8" I. PIN (R/W)
SET: ● 5/8" I. PIN w/YELLOW CAP
SCALE: 1" = 100.0'
DATE: MARCH 16, 1981

SURVEYOR'S CERTIFICATE:

I, KURT C. WEAVER, A REGISTERED PROFESSIONAL LAND SURVEYOR
IN THE STATE OF OREGON, HEREBY CERTIFY THAT THIS IS A CORRECT
REPRESENTATION OF A SURVEY MADE UNDER MY DIRECTION AND IT
HAS BEEN CORRECTLY EXECUTED WITHIN THE REQUIREMENTS AND
REGULATIONS OF THE STATE OF OREGON.

Kurt C. Weaver

KURT C. WEAVER
REGISTERED PROFESSIONAL LAND SURVEYOR
OREGON LICENSE 1679

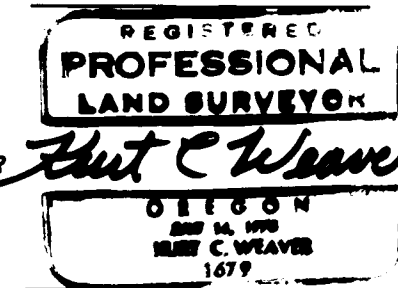

APPROVAL:

APPROVED BY JACKSON COUNTY DEPARTMENT OF PLANNING AND
DEVELOPMENT, ROBERT BRITZMAN, PLANNING DIRECTOR (FILE NO.
81-5-MP),

BY *Robert Britzman*
DATE *April 6*, 1981.

FILED FOR RECORD THIS 9 DAY OF April, 1981,
AT 4:29 P. M. AND RECORDED IN VOL. 4, PAGE 12,
OF "MINOR LAND PARTITIONS" IN JACKSON CO., OREGON.


Waldene Turrey
COUNTY CLERK

BY: *Betty Kay Deputy*



I hereby certify that this plat is a true representation of
the original plat as _____
amended by the AFFIDAVIT recorded as instrument no.
O.R. 81-19330 of Official Records of Jackson
County, Oregon.

Kurt C. Weaver
KURT C. WEAVER

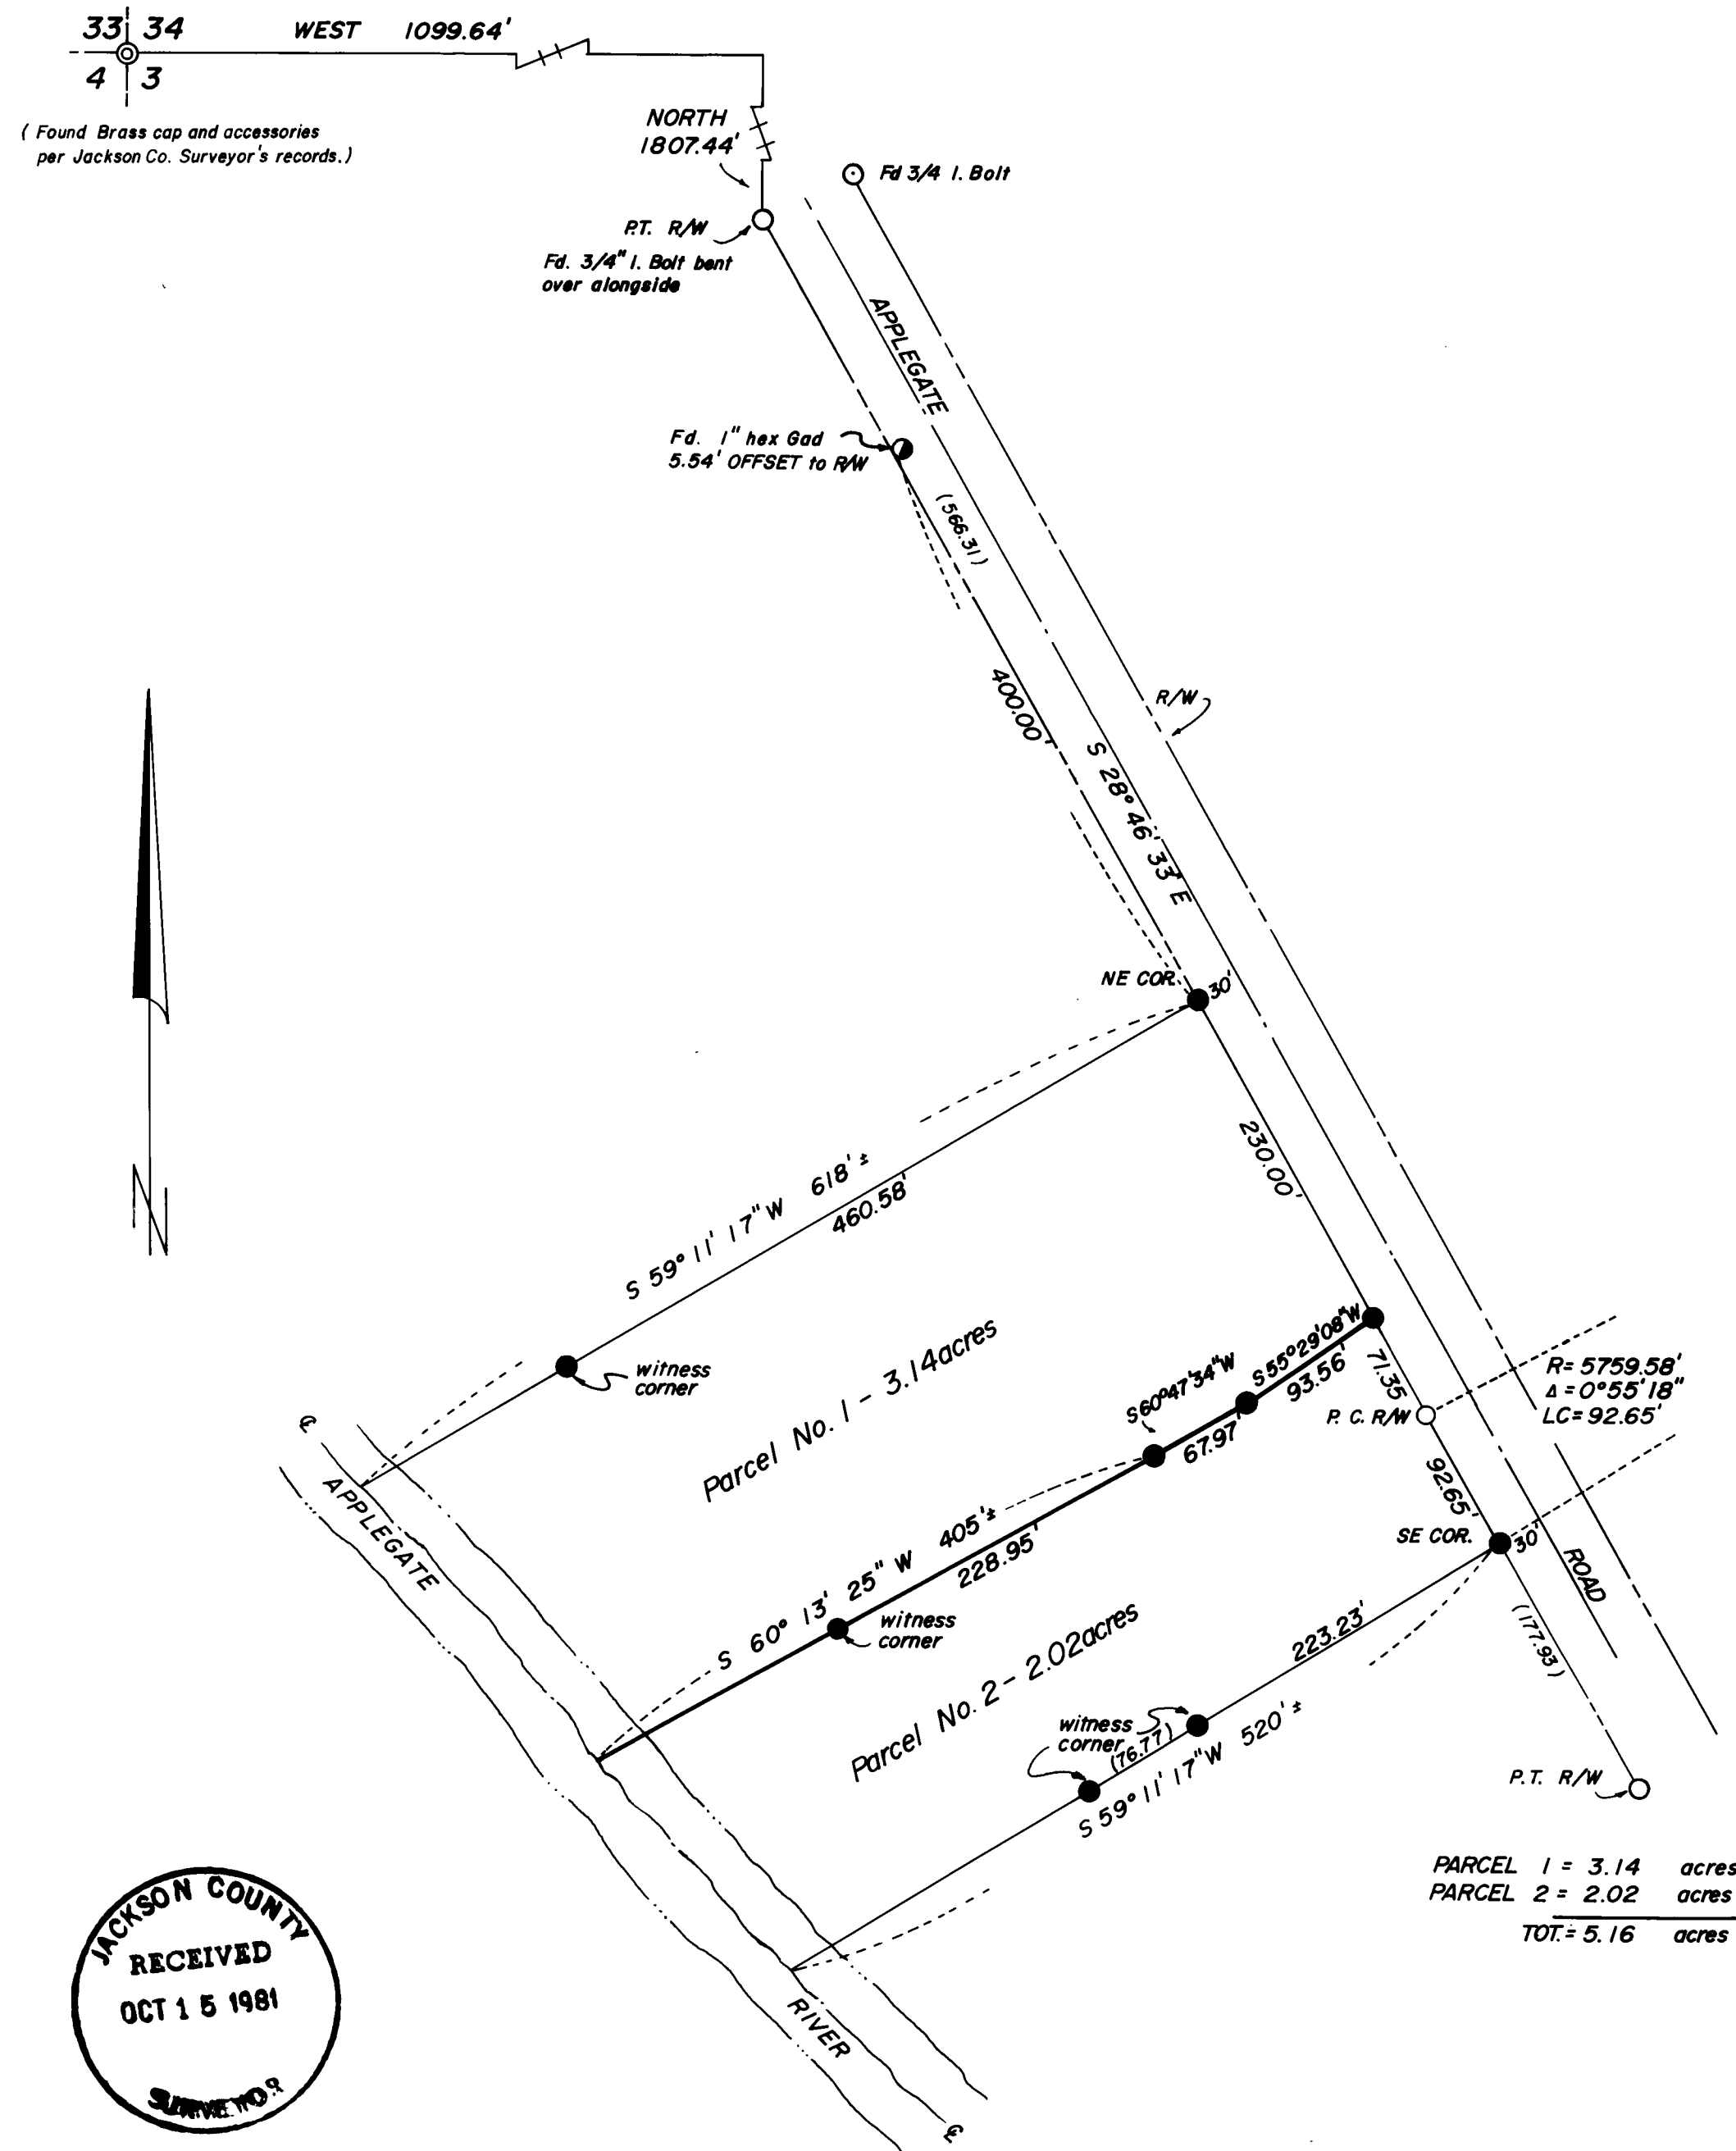

PARCEL 1 = 3.14 acres
PARCEL 2 = 2.02 acres
TOT = 5.16 acres

AFFIDAVIT

STATE OF OREGON)
County of Jackson) ss

I, Kurt C. Weaver, being first duly sworn, do depose and say:

The Minor Land Partition Plat recorded in Volume 4 at Page 12 of "Minor Land Partitions" in Jackson County, Oregon should be amended as follows: That information shown in parenthesis on the map below is additional data that should appear on the original plat.

Dated this 14th day of October, 1981.

REGISTERED
PROFESSIONAL
LAND SURVEYOR


Kurt C. Weaver

OREGON
JAN 14, 1978
KURT C. WEAVER
1679

Kurt C. Weaver
Kurt C. Weaver

subscribed and sworn before me this 14th day of October, 1981.

M. Lisa Flatebo
M. LISA FLATEBO
NOTARY PUBLIC - OREGON
MY COMMISSION EXPIRES 7/6/85

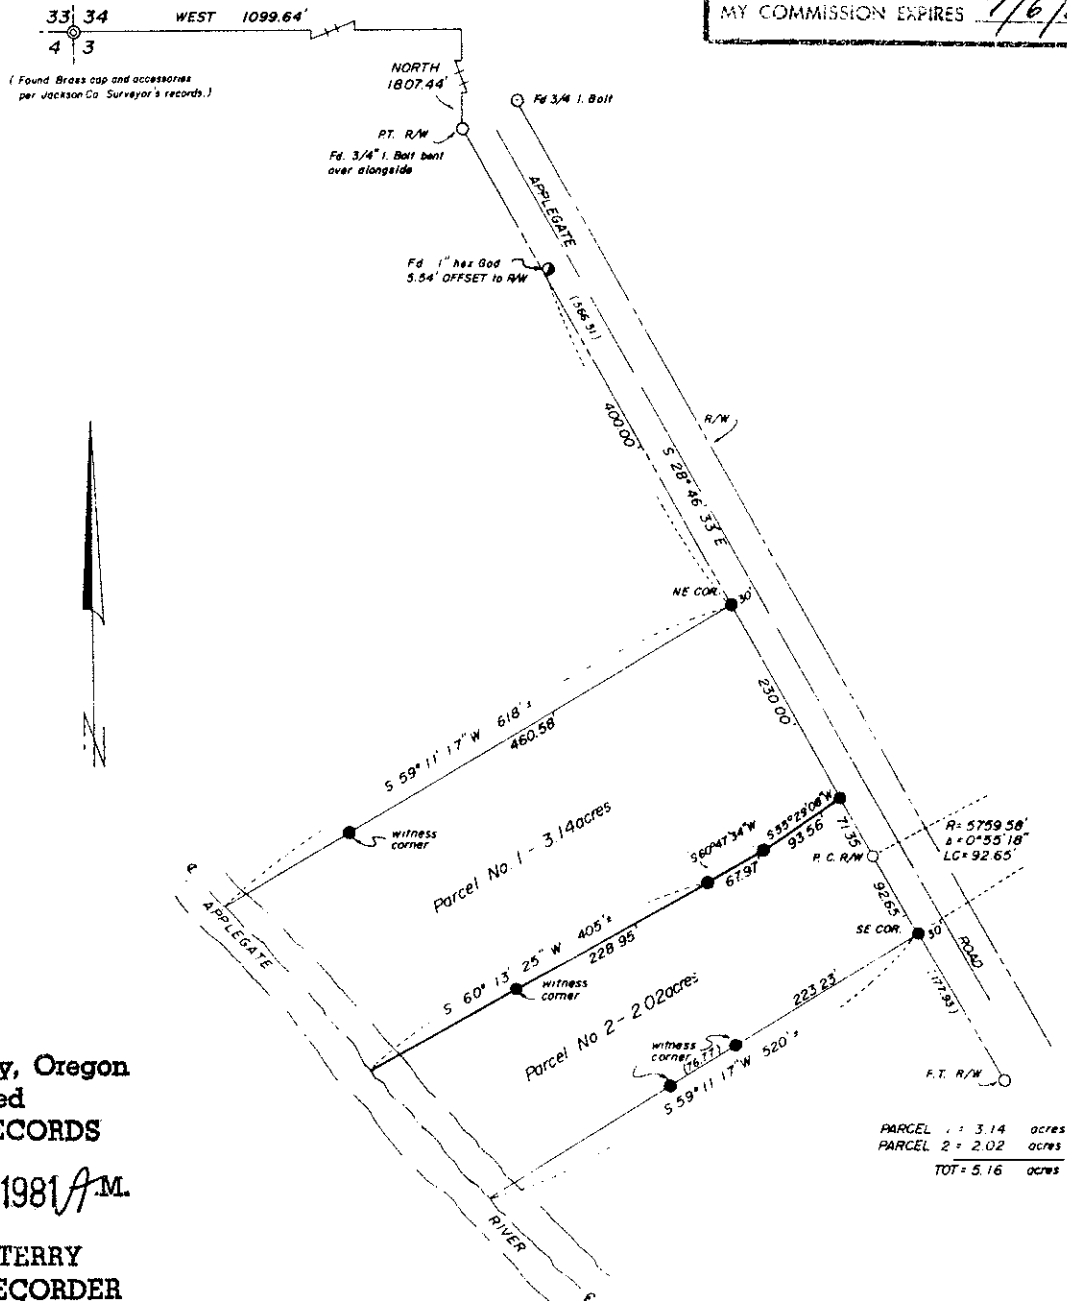

Jackson County, Oregon
Recorded
OFFICIAL RECORDS

11:38 OCT 15 1981 A.M.

WALDENE TERRY
CLERK and RECORDER

By *Joy A. Ramler* Deputy