


Fd 5/8" I PIN
Survey# 4194

N 89°27'00"W 1334.94' (RECORD)
1008.96'

21 22
28 27
Fd. 2" G.I. PIPE
& Accessories Per. Co. Records

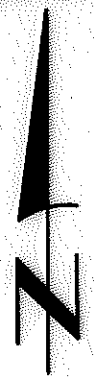

MAP OF SURVEY
FOR
Mr. JOHN LUND
LOCATED IN N.E. 1/4 Sec. 28, T.38S., R.3W., W.M.
JACKSON CO. OREGON
SCALE : 1" = 100'
DATE : OCTOBER 15 1981
● = SET 5/8" X 24" I. PIN
BASIS OF BEARING SURVEY NO. 3912

500°03'28"W 348.96'


Fd. 5/8"
I Pin
Survey # 4966

N 89°50'20"W 807.46'
757.40'

N.E. Cor.
D.L.G. 38
Fd.
1 1/2" I. PIPE
& Accessories
Per. Co. Records

S 130°01'37"E 311.81'

N 00°20'50"E 678.75'

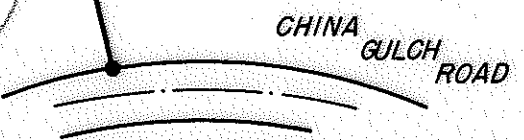

Survey # 3912
Fd. 5/8" I. Pin
Witness Cor.

REGISTERED
PROFESSIONAL
LAND SURVEYOR
Kurt C. Weaver
OREGON
JULY 14, 1978
KURT C. WEAVER
1679

JACKSON COUNTY
RECEIVED
OCT 29 1981
SURVEYOR

Survey No. 9052

SURVEY NARRATIVE TO COMPLY WITH O.R.S. 209.250

Survey For: Mr. John Lund
444 China Gulch Road
Jacksonville, OR 97501

Location: Located in the Northeast quarter, Section 28,
Township 38 South, Range 3 West, Willamette
Meridian, Jackson County, Oregon.

Purpose: To establish the westerly boundary of Mr. John
Lunds parcel.

Procedure: From previous surveys, we found monuments and
verified there positions in the field. Using
these monuments for control, we set 5/8" x 24"
iron pins as shown on the accompanying plat.
Filed Survey No. 3912 was used for basis of bear-
ing.

Surveyed By: T. Flatebo and Associates, Inc.
P.O. Box 900
Jacksonville, OR 97530

Date: October 15, 1981

