

- ① N 8°26'21"W, 10.66'
- ② S 17°13'15"W, 42.79'
- ③ S 11°48'40"W, 39.31'
- ④ S 8°04'W, 56.11'
- ⑤ S 1°31'50"W, 59.87'
- ⑥ S 5°25'20"E, 45.74'

INST. NO. ① 77-06099 O.R.
(TRACT A-1)

FILED SURVEY
NO. 5081

FILED SURVEY
NO. 4021

LEASE PARCEL "A"
0.91 AC. ±

Southwest Corner of
Inst. No. 73-04996 O.R.

LEASE PARCEL "B"
2.71 AC. ±

South, 239.03' and
East, 704.31' from
the N.W. Corner of
Section 20

FILED SURVEY
NO. 6236

LEASE PARCEL "C"
0.36 AC.


E AGATE ROAD

18
19
17
20

SECTION CORNER
C.S. Bronze Disk
in concrete pavement

SURVEY FOR:
BOISE CASCADE CORPORATION
LOCATED IN THE S.W. 1/4 OF SECTION 17
AND THE N.W. 1/4 OF SECTION 20, T.36S., R.1W., W.M.

BY: BOYDEN SURVEYORS
NOVEMBER 4, 1981

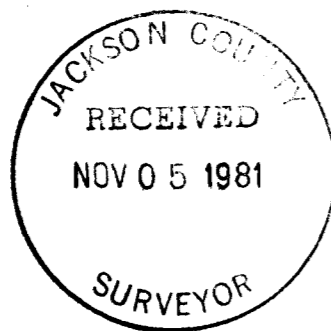

SCALE: 1"=100'
BASIS OF BEARINGS:
FILED SURVEY NO. 8667

- = FOUND 5/8" REBAR SET IN CONCRETE
W/PLASTIC CAP MARKED
"BOYDEN R.L.S. 281"
- = SET 5/8" x 24" REBAR
W/PLASTIC CAP MARKED
"KAISER R.L.S. 803"

REGISTERED
PROFESSIONAL
LAND SURVEYOR

Sam D. Kaiser

OREGON
JULY 16, 1987
GARY D. KAISER
No. 803

Survey No. 19065

SURVEY NARRATIVE TO COMPLY WITH O.R.S. 209.250

FOR: Boise Cascade Corporation
P. O. Box 100
Medford, Oregon

BY: Boyden Surveyors
108 Mistletoe Street
Medford, Oregon

PURPOSE: To monument and describe three proposed lease parcels located in Sections 17 and 20, T36SR1W, W.M.

PROCEDURE: Utilizing controls remonumented on Filed Survey No. 8667, the desired three lease parcels were computed and monumented as shown on the annexed map. Lease Parcel "A" was not entirely monumented in that existing railroad tracks defined the Northerly, Easterly and Westerly boundaries.

Basis of Bearings is Filed Survey No. 8667.

November 4, 1981

REGISTERED
PROFESSIONAL
LAND SURVEYOR

Gary D. Kaiser

OREGON
JULY 18, 1967
GARY D. KAISER
No 803

