


"P" LINE SURVEY BY THE DEPT. OF PUBLIC WORKS

NOTE: ACREAGE COMPUTED TO DEPT. OF PUBLIC WORKS "P" LINE SURVEY OF PLEASANT CREEK ROAD.

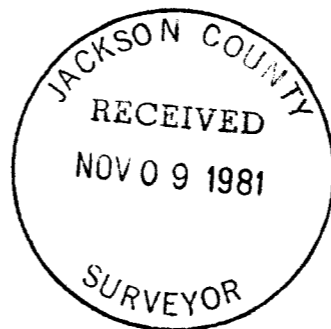

SURVEY FOR: RON SIEBERT	
LOCATION: NE, NW & SW 1/4 Sec. 22, T. 34 S., R. 4 W., W.M. JACKSON COUNTY, OREGON	
DATE: October 30, 1981	
SCALE: 1"=300'	
● 5/8" STEEL PIN FOUND EXCEPT WHERE NOTED	
○ 5/8" x 30" STEEL PIN SET	
() RECORD DISTANCE	
X—X—X FENCE LINE	
REGISTERED PROFESSIONAL LAND SURVEYOR <i>Darrel W. Edwards</i> OREGON JULY 8, 1936 DARREL W. EDWARDS 741	

(New Attached) 3d dx 22

SURVEY NO. 9071

SURVEY NARRATIVE TO COMPLY WITH PARAGRAPH 209.250, OREGON REVISED STATUTES

SURVEY FOR: Ron Siebert
573 $\frac{1}{4}$ Pleasant Creek
Rogue River, OR 97537

LOCATION: Northeast, Northwest and Southwest $\frac{1}{4}$, Section 22, Township
 $\frac{3}{4}$ South, Range $\frac{1}{4}$ West of the Willamette Meridian, Jackson
County, Oregon.

PURPOSE: Lot line adjustment and property survey. To locate and monument
the property boundaries of the Siebert property as shown on the
accompanying plat.


PROCEDURE: I found the monuments as shown. Using said monuments, Deed
Records and control established in R.S. 8136, I set $\frac{5}{8}$ " x 30"
steel pins with plastic caps as shown on the accompanying plat.

EQUIPMENT: Lietz TM-20C Theodolite and Lietz Red-1 EDM.

BASIS OF
BEARINGS: R.S. 8136

DATE COMPLETED: October 30, 1981

Darrel W. Edwards
P. O. Box 801
Rogue River, OR 97537
Telephone 582-3110

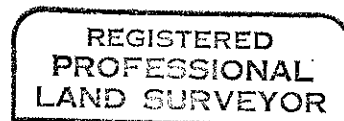

Darrel W. Edwards

