

9092

Survey for Clyde Severson

Located in the S.W. 1/4 Sec. 29, T.36S., R.1W., W.M., Jackson County, Oregon

October 30, 1981

1/4 Cor.
30 29
5/8" I. Pin

OLD CRATER LAKE
HIGHWAY

N 0° 19' 30" W

R/W

S 89° 41' 35" E

650.00

30

122.00

30 29
31 32

Br. Cap in
Mon. Case

650.00

S 89° 41' 35" E

122.00

1/4 Cor.

29

32



1" Pipe
12" Deep

LEGEND

- 5/8"x 24" iron pin set
- Monument Found

BASIS OF BEARINGS

Recorded Survey No. 3252

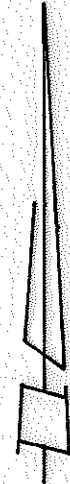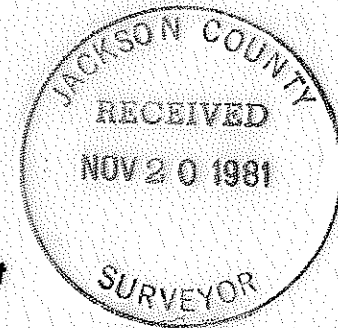

Scale: 1" = 100'



Verlyn Thomas
 OREGON
 MAY 13, 1960
 VERLYN D. THOMAS
 505

Survey by Verlyn Thomas, Professional Land Surveyor, Medford, Oregon

(Narr. Attached)

TL 1804 36 1W 29C

9092

SURVEY NO. 9092

SURVEY NARRATIVE TO COMPLY WITH O.R.S. 209.250

SURVEY FOR: Clyde Severson
2817 East McAndrews Road
Medford, Oregon

PURPOSE: To monument a parcel according to legal description furnished
by client.

PROCEDURE: Recovered 1/4 corner between Sections 29 and 32, the corner
common to Sections 29, 30, 31, 32, and the 1/4 corner between
Sections 29 and 30.

Monumented parcel as shown on the accompanying plat.

Verlyn Thomas
Professional Land Surveyor
304 South Holly
Medford, Ore. 97501
Phone 773-8866

