

9606

SURVEY SITUATE IN THE SW 1/4 OF SECTION 36  
T. 40 S., R. 3 E., W.M., JACKSON COUNTY, ORE.

FOR: JOHN D. BOWMAN

SURVEY BY  
Charles H. Hurst, L.S.  
Medford, Oregon

REGISTERED  
PROFESSIONAL  
LAND SURVEYOR

*Charles H. Hurst*

OREGON  
OCTOBER 30, 1959  
CHARLES H. HURST  
483

Fd. 1/4 Cor.  
1974 CS Br. Cap  
Mon.


25

36

LEGEND

- Set 5/8" x 24" iron pins
- ▲ Set 3/4" x 30" iron pins

SCALE: 1" = 500'

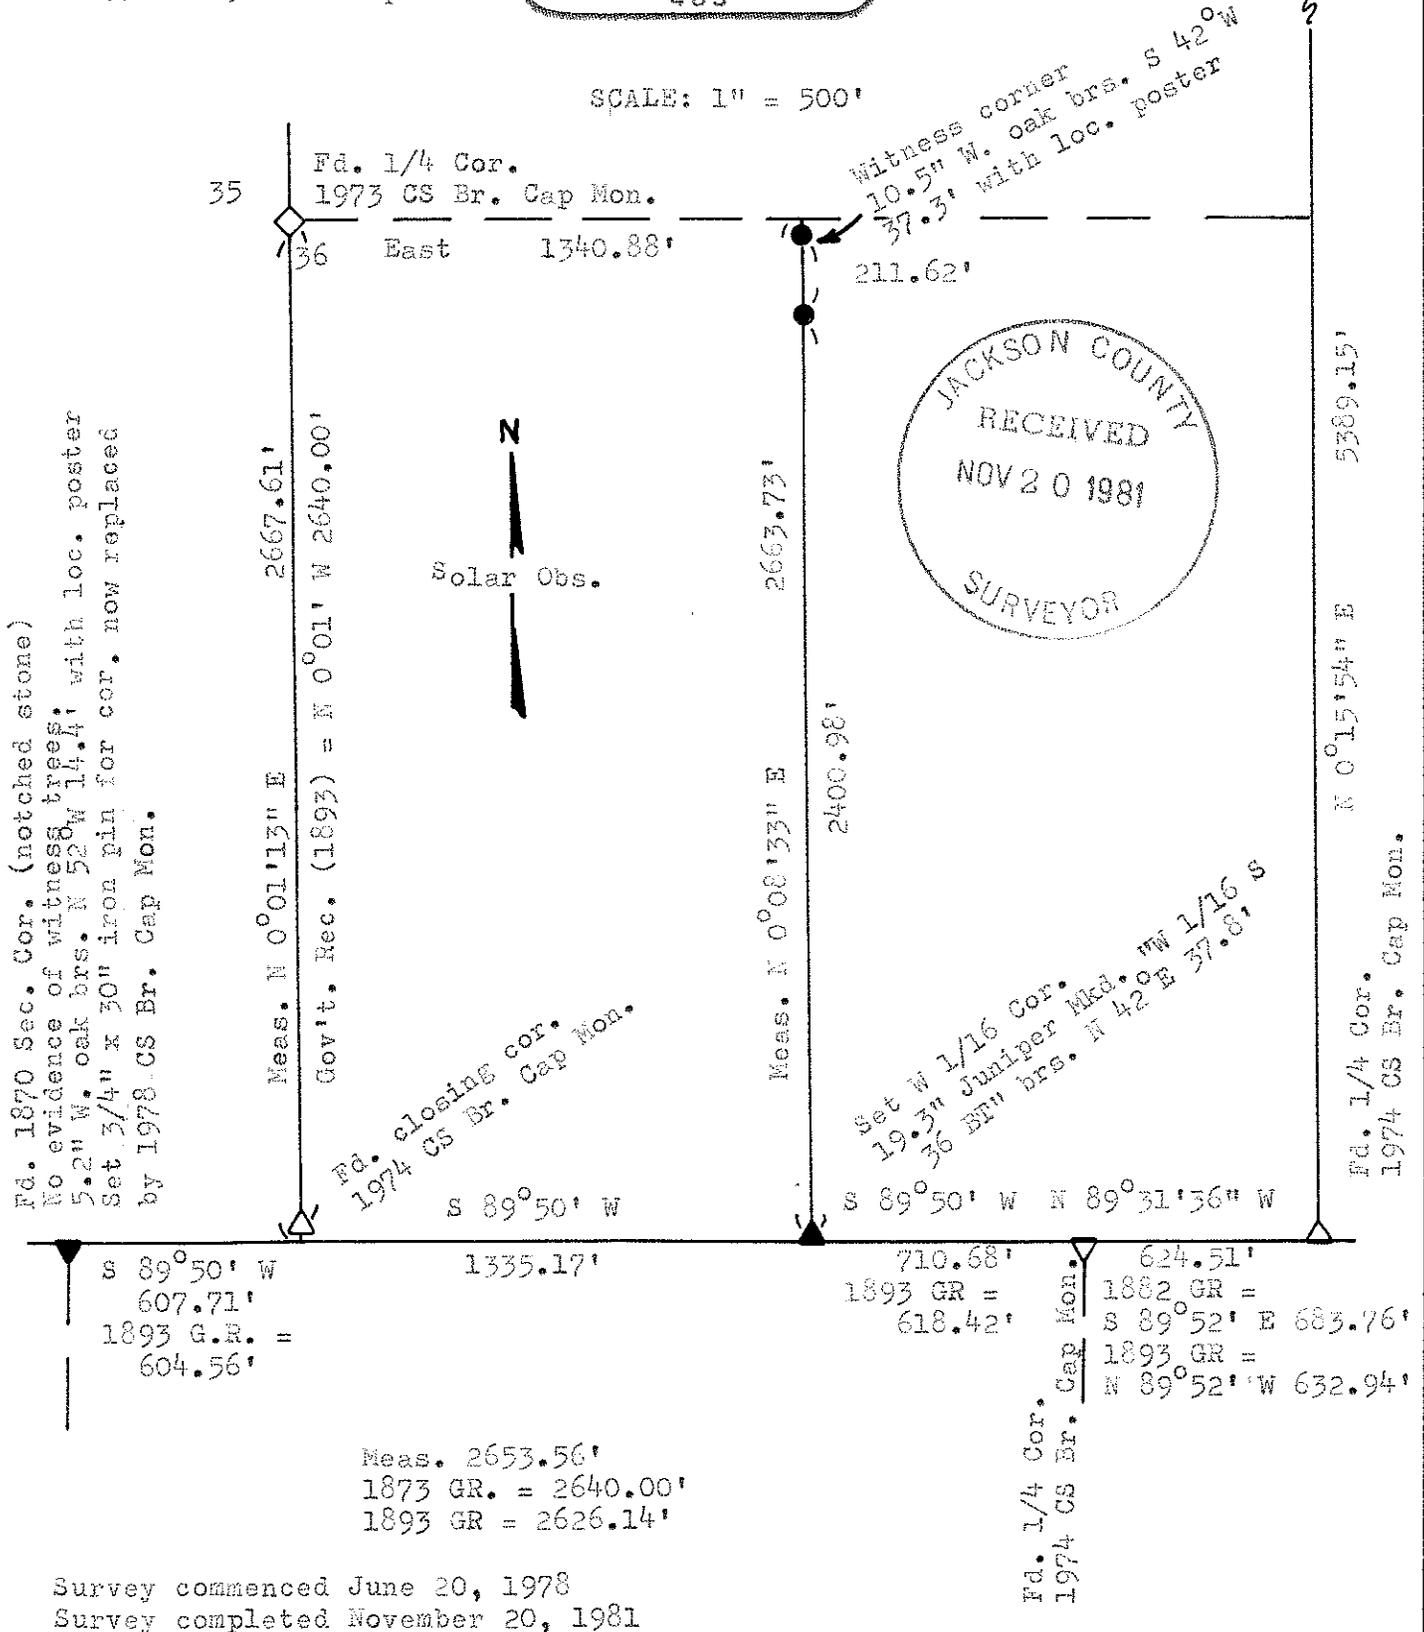

9606

(Name Attached) 40 3E

SURVEY NARRATIVE TO COMPLY WITH PARAGRAPH 209.250  
OREGON REVISED STATUTES

- Survey for: John D. Bowman  
Box 958  
Eagle River, Alaska 99577
- Survey by : Charles H. Hurst  
304 South Holly  
Medford, Oregon 97501
- Bearings : Based on a series of solar observations
- Purpose : To define the east line of the West Half of the South-  
west Quarter of Section 36 for the purpose of fence  
line construction.



Procedure

Corner ties were obtained utilizing electronic distance measuring equipment.

The client initially was desirous of setting the CW 1/16 corner of Section 36 which would have required appropriate additional work.

Economic considerations apparently considered, such additional work was not mutually agreed upon and the plat of survey was completed in the absence of a response from the client.

November 20, 1981

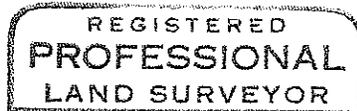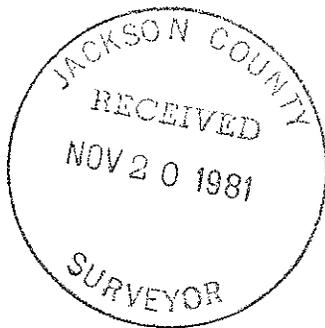

*Charles H. Hurst*

