(East 614.90')

( North

15

22

14

23

WARDS CREEK ROAD

PLAT OF SURVEY

VIRGINIA BURCH

located in the

SCALE | "= 100"


**NOVEMBER 23, 1981** 

REGISTERED
PROFESSIONAL
LAND SURVEYOR

OREGON

DARREL W. EDWARDS 741

for

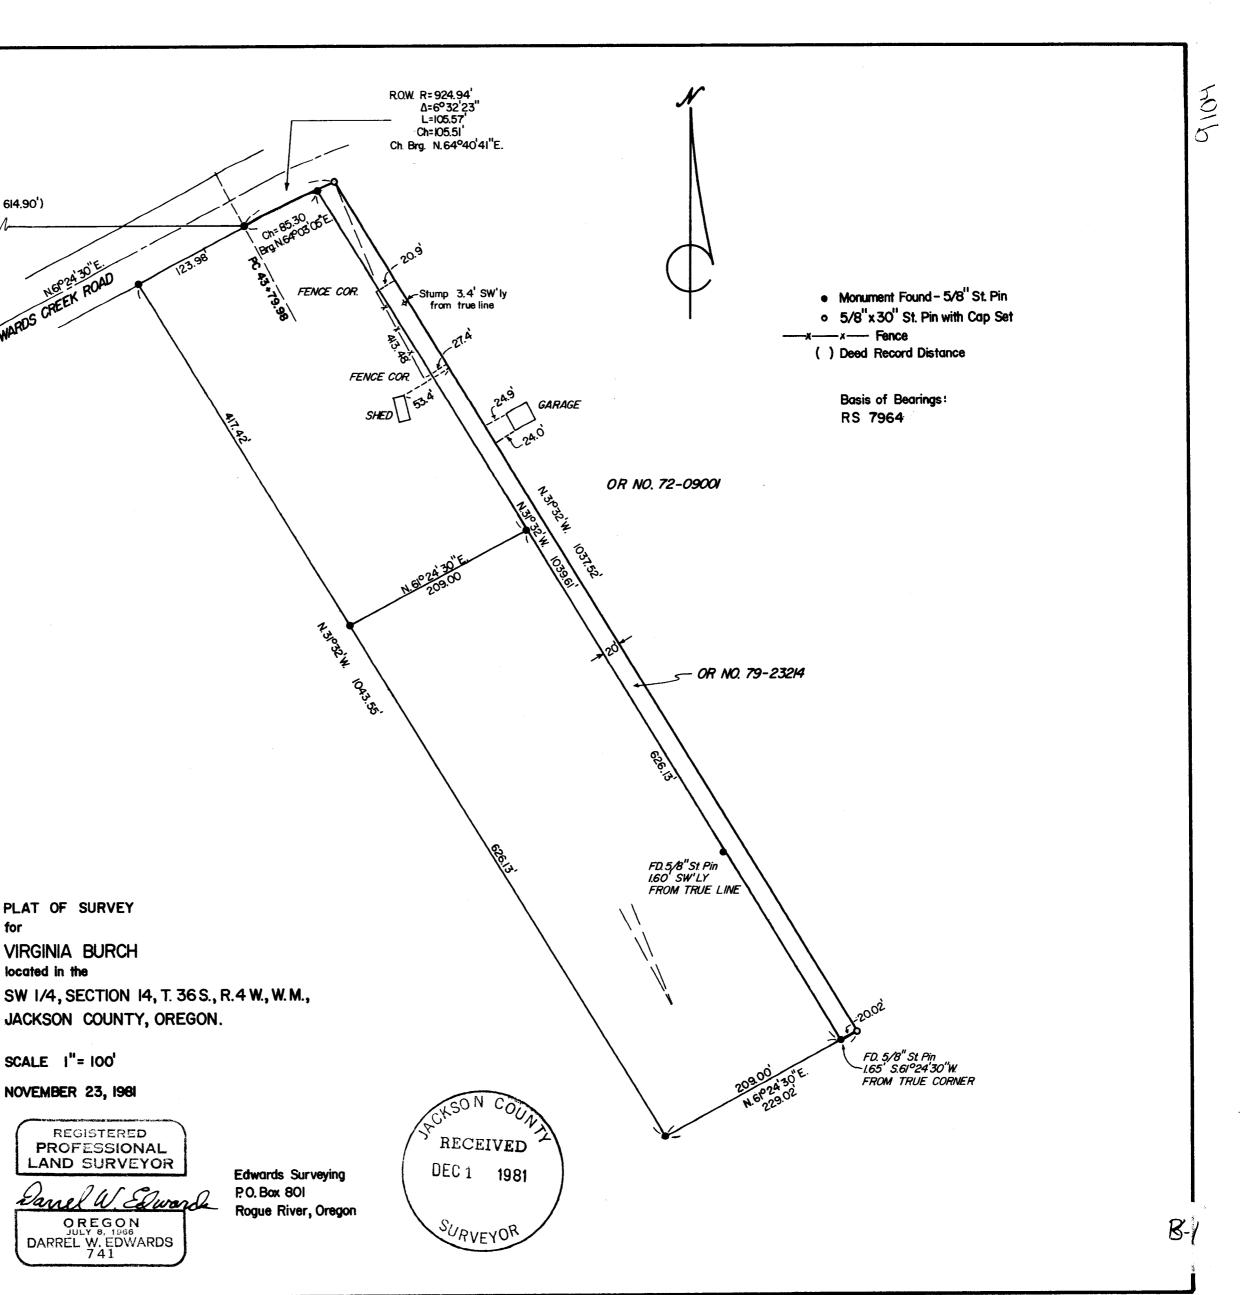

(NATE attached) TK 9401 & 9402 36 4W 14 9104

SURVEY NARRATIVE TO COMPLY WITH PARAGRAPH 209.250, OREGON REVISED STATUTES.

SURVEY FOR:

Virginia Burch 946 Wards Cr. Rd. Rogue River, Or.

LOCATION:

SW 1/4 Section 14, T. 36 S., R. 4 W.W.M., Jackson County, Oregon.

PURPOSE:

To locate and monument the East Line of a parcel of land described in Document No. 79-23214 of the Official Records of Jackson County, Oregon. Also to locate certain improvements to determine if any encroachments exist.

PROCEDURE:

I found the monuments as shown. Using said monuments and Deed Records I set 5/8" x 30" steel pins with caps stamped "D.W. Edwards\*L.S. 741". From these corners I located the improvements as shown on the accompanying plat.

EQUIPMENT:

Lietz TM-20C theodolite and Lietz Red-1 EDM.

BASIS OF

BEARINGS:

R.S. 7964

DATE COMPLETED: November 23, 1981

Darrel W. Edwards P.O. Box 801 Rogue River, Oregon Tel: 582-3110

REGISTERED PROFESSIONAL LAND SURVEYOR

DARREL W. Edwards

OREGON

JULY 8, 1968

DARREL W. EDWARDS

741

RECEIVED

DEC 1 1981

SURVEYOR