

Basis of Bearings: RS 8250

11.76 Ac.  
- .88 Ac. in road  
10.88 Ac. net

- Monument Found 5/8" St. Pin unless otherwise noted
- 5/8" x 30" Steel Pin with Cap Set

PLAT OF SURVEY  
for  
GREGG ADAMS  
located in the  
NE 1/4 SECTION 3, T. 37S., R. 1W., W.M.,  
JACKSON COUNTY, OREGON

Scale 1" = 200'

November 23, 1981

Edwards Surveying  
P.O. Box 801  
Rogue River, Oregon



REGISTERED  
PROFESSIONAL  
LAND SURVEYOR

*Darrel W. Edwards*  
OREGON  
JULY 8, 1976  
DARREL W. EDWARDS  
741

B-1

SURVEY NO. 9103

SURVEY NARRATIVE TO COMPLY WITH PARAGRAPH 209.250, OREGON REVISED STATUTES

SURVEY FOR: Gregg Adams  
2120 Oakwood Drive  
Medford, OR 97501

LOCATION: Northeast quarter of Section 3, Township 37 South, Range 1 West of  
the Willamette Meridian, Jackson County, Oregon

PURPOSE: Lot line adjustment. To locate and monument the new property line  
as shown on the accompanying plat.



PROCEDURE: Using control established and monuments set in R.S. 8250 I set  
5/8" x 30" steel pins with caps as shown on the accompanying plat.

EQUIPMENT: Lietz TM-20C Theodolite and Lietz Red-1 EDM

BASIS OF  
BEARINGS: R.S. 8250

DATE COMPLETED: November 23, 1981

Darrel W. Edwards  
P. O. Box 801  
Rogue River, OR 97537  
Telephone 582-3110

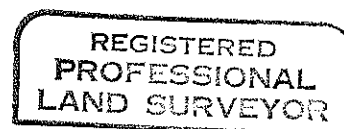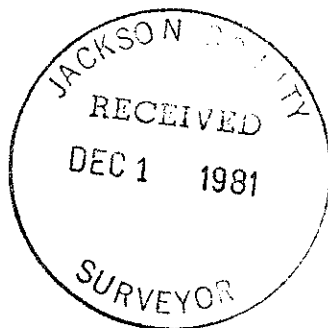

*Darrel W. Edwards*

