


CERTIFIED RECORD OF LAND CORNER MONUMENTATION

History of original corner establishment:

The section line between Sections 31 and 32, Township 40 South, Range 1 West, Willamette Meridian was surveyed by Rufus S. Moore under Contract No. 475, plat approved April 10, 1884. During the course of running this line, Moore called for 'a Fir, 60 ins. in diam.' at 55.97 chains North of the Southeast Corner of Section 31.

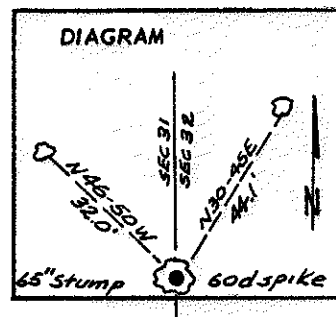

Description of corner evidence found:

Edward A. McGinty, PLS 301, on Recorded Survey No. 5506 found this line tree as referred to by Moore. During the course of a survey to locate the Northeast Corner of said Section 31, I was asked to reference this original line tree. From a closed traverse the tree was identified from both the original surveyors' calls and from data as shown on McGinty's Map of Survey. The tree, now a 65" Fir stump is referenced as stated below.

Description of monument and accessories I established to perpetuate the original location of this corner

Set a 60d common spike in the center of the stump, from which the following B.T.'s were marked:

- a 14" Shasta Red Fir bears N30°45'E, 44.1 ft., scribed 'AP S32' 'BT'
- an 11" Shasta Red Fir bears N46°50'W, 32.0 ft., scribed 'AP S31' 'BT'

A 3/4" brass washer stamped 'LS601' was nailed into the lower face of each B.T. I painted a 6" red band around, placed B.T. tags, and Attention Signs on both B.T.'s.

This line tree is located approximately N9°E, 116' from switch-back in Wrangle Camp Road, just below the camp area.

REGISTERED  
PROFESSIONAL  
LAND SURVEYOR  
*Malcolm M. Clark*  
OREGON  
JULY 12, 1963  
MALCOLM N. CLARK  
601

Office of ..... County of .....  
State of ....., I hereby certify that the within instrument was filed in this office  
for record on the ..... day of .....  
..... by .....  
(COUNTY OFFICIAL) (DEPUTY)

