


MAP OF SURVEY

LOCATED IN THE SW. 1/4 OF SECTION 18, T. 39 S., R. 2 W., W. M., JACKSON COUNTY, OREGON

FOR

T&K PROPERTIES

BASIS OF BEARING: SURVEY No. 8386  
 FOUND: ○ 2 1/2" BRASS CAP  
 ● 5/8" IRON PIN  
 SET: ● 5/8" IRON PIN  
 SCALE: 1" = 200'  
 DATE: OCTOBER 19, 1981

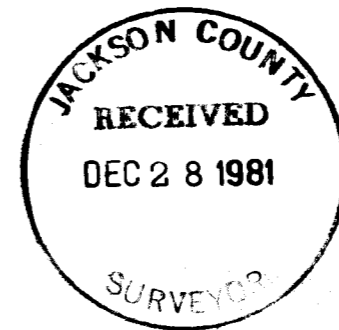

REGISTERED PROFESSIONAL LAND SURVEYOR

*Kurt C. Weaver*  
 OREGON  
 JULY 14, 1978  
 KURT C. WEAVER  
 1679

SURVEY NO. 9143

SURVEY NARRATIVE TO COMPLY WITH O.R.S. 209.250

Survey For: T & K Properties  
P.O. Box 900  
Jacksonville, OR 97530

Location: Located in the Southwest quarter of Section 18,  
Township 39 South, Range 2 West of the Willa-  
mette Meridian, Jackson County, Oregon.

Purpose: To survey, monument and mark the parcels shown  
on the accompanying map.

Procedure: Utilizing control established during the sub-  
division of Section 18 (see Survey No. 8386)  
I set the corners and marked the lines of the  
said parcels. Accessaries as per Survey No.  
8386. Basis of bearing was based on Survey  
No. 8386.

Surveyed By: T. Flatebo & Associates, Inc.  
P.O. Box 900  
Jacksonville, OR 97530

Phone No. 899-8267

Date: October 19, 1981

