

MAP OF SURVEY
 LOCATED IN
 S.W. 1/4 of SEC. 28, T.35 S., R. 2 W., W.M.
 JACKSON COUNTY, OREGON
 FOR
GREG W. FRANZ

HOFFBUHR/BATH & ASSOCIATES, INC.
 219 N. OAKDALE MEDFORD, OREGON
 BY: RICHARD L. BATH R.P.L.S. NO. 1069
 SCALE: 1" = 400' JANUARY 6, 1982
 BASIS OF BEARING S/N 8532

○ = Set 5/8" x 24" Iron Pin w/yellow plastic caps tagged "R.BATH L.S. 1069" for Witness Monuments
 S/N = Survey No.

REGISTERED
PROFESSIONAL
LAND SURVEYOR

Richard L. Bath

OREGON
 JULY 30, 1976
 RICHARD L. BATH
 No. 1069

JACKSON COUNTY
 RECEIVED
 JAN 19 1982
 SURVEYOR

See attached narrative

35 2w 28

SURVEY NO. 9163

SURVEY NARRATIVE TO COMPLY WITH PARAGRAPH 209.250
OREGON REVISED STATUTES

SURVEY FOR: Greg W. Franz
6733 Old Stage Road
Central Point, Oregon 97502



LOCATION: Southwest one-quarter (1/4) of Section 28,
Township 35 South, Range 2 West, Willamette
Meridian, Jackson County, Oregon

PURPOSE: To establish the West one-sixteen (1/16)
corner between Section 28 and Section 33,
and to monument the one-sixteen (1/16) line
North to Perry Road per client's request


PROCEDURE: Measured distance between the Southwest corner
of Section 28 and the South one-quarter (1/4) corner of Section
28, and set West one-sixteen (1/16) corner at one half the dis-
tance. Then, using a bearing determined from Survey No. 8532,
set witness points from the West one-sixteen (1/16) corner North
to Perry Road as shown on the attached map. It was not the in-
tention of this survey to determine the road right of way lines.

Basis of Bearing: Survey No. 8532

January 6, 1982

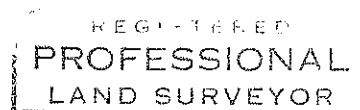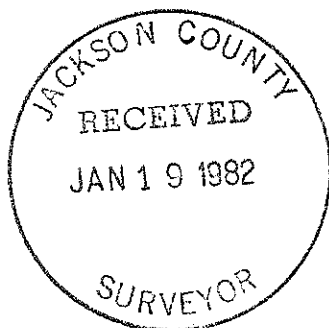

Richard L. Bath

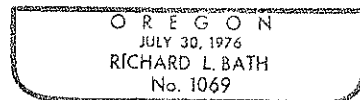

Richard L. Bath
Hoffbuhr/Bath & Associates, Inc.
219 North Oakdale
Medford, Oregon 97501

See attached map