
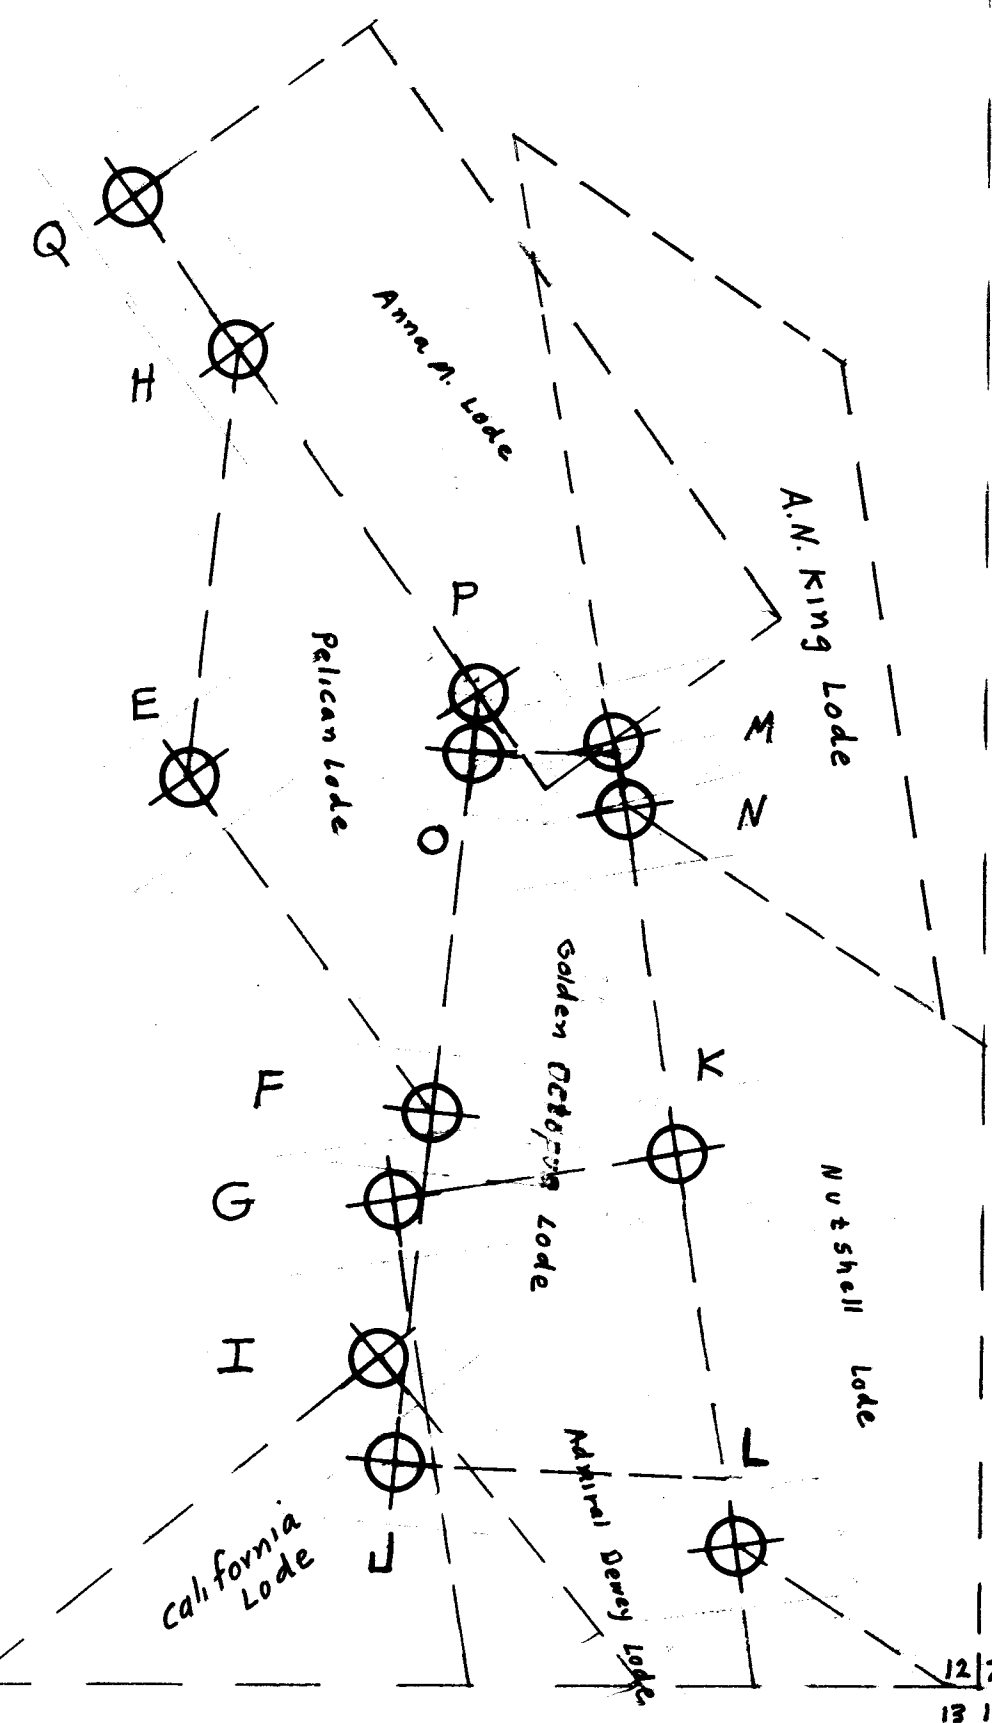


2 1
11 12

1 6
12 7

Section 12, Township 39 S., Range 1 W. W.M.
Scale 1 inch = 400 feet

⊕ = Corners Set (re-established
from U.S. Mineral Surveys 377,
569 & 414) 5/8" x 30" or 24" iron rods

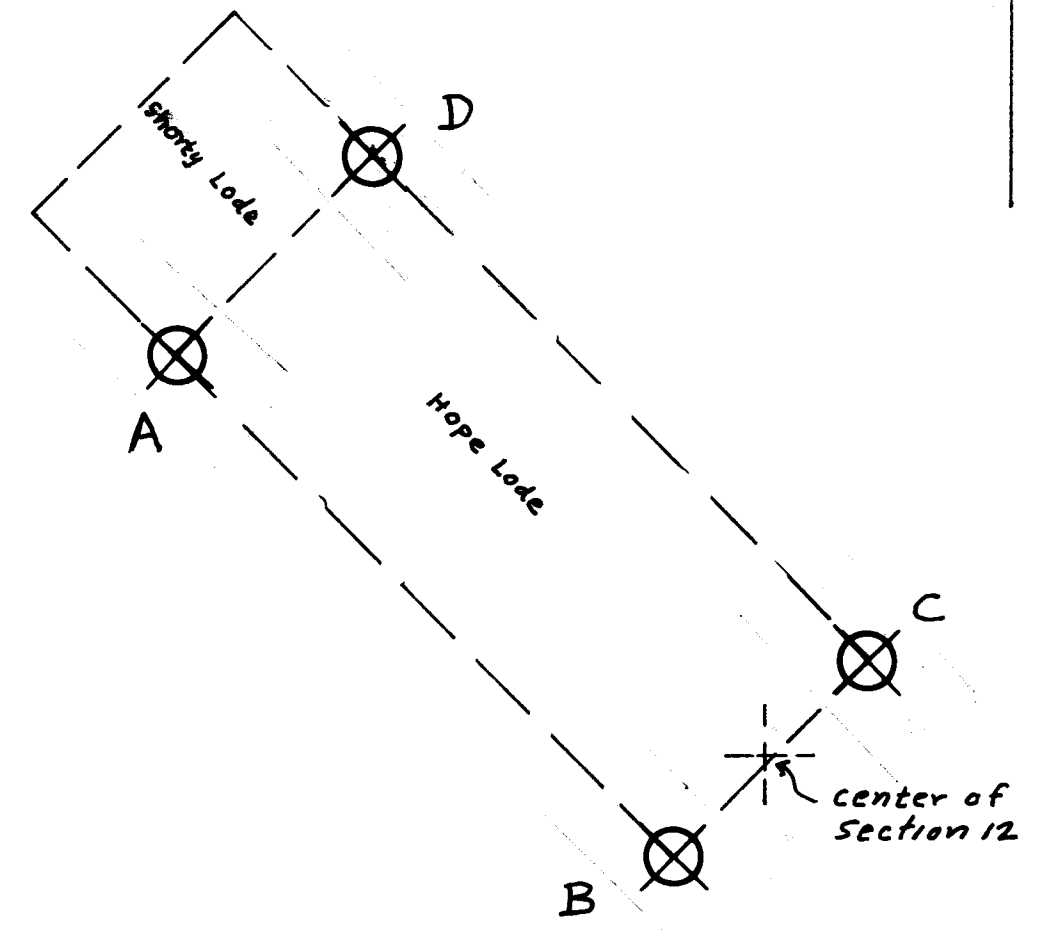

Surveyed By: P.B. Wickham R.L.S. 664
Surveyed For: P.B. Wickham
PO Box 564
Grants Pass OR. 97526
Date: January 1982

REGISTERED
PROFESSIONAL
LAND SURVEYOR

Philip B. Wickham

OREGON
JULY 10, 1964
PHILIP B. WICKHAM
664

** RECEIVED **
Date 2/5/82 By SLK
This survey consists of:
1 sheet(s) Map
2 page(s) Narrative
JACKSON COUNTY
SURVEYOR

11 12
14 13

12 7
13 18

9212

- O. Corner #4 Golden Octopus Claim
Found stump remains of 48" fir
Found root-wad of 22" Black Oak
Set 5/8 inch X 30" Iron Rod, 24" in the ground from which;
a 13.5" Madrone bears N. $14^{\circ}30'$ E., 34.80 feet
A 15.5" Madrone bears N. $65^{\circ}30'$ E., 13.14 feet (behind old 24"
Pine snag) 15.5" Madrone has large fork sawed off $4\frac{1}{2}$ feet
above fork.
Corner is about 350' below road
- P. Corner #1 Pelican Lode
Found 38" Yellow Pine, now a snag
Set 5/8 inch X 30" Iron Rod, 24" in the ground from which;
An 11.5" Madrone bears N. $75^{\circ}30'$ E., 24.25 feet
A 14.0" Douglas-fir bears S. 22° W., 3.2 feet
- Q. Corner #3 Anna M. Lode (N.W. Corner)
Found original Black Oak BTs alive, with rotted blaze-faces
Found mound of rock with remains of post
Set 5/8 inch X 24" Iron Rod with yellow cap, 4" exposed from which
new BTs marked "3 377" on top blaze and "BT" on bottom blaze are:
A 14" Ponderosa Pine bears S. $89^{\circ}45'$ W., 28.80 feet
An 18" Madrone bears N. 66° W., 62.60 feet
The 18" Madrone is approximately 10 feet N.W. of skid trail at
West edge of large rock outcrop near ridge top.

REGISTERED
PROFESSIONAL
LAND SURVEYOR

Philip B. Wickham

OREGON
JULY 10, 1964
PHILIP B. WICKHAM
664

** RECEIVED **
Date 2/5/82 By SK
This survey consists of:
1 sheet(s) Map
7 page(s) Narrative
JACKSON COUNTY
SURVEYOR

- K. Corner #4, Admiral Dewey
 Found both original BTs: A 24" Madrone now 28" and a Pine 10" now 16" with scribing visible.
 I set a 5/8 inch X 30" Iron Rod 24" in the ground from which re-scribed bearing trees:
 A 28" Madrone bears S. 17° E., 19.45 feet
 * An 16" Pine bears S. 20° W., 16.50 feet
 Corner is above road and old logging landing about 100 feet.
- L. Corner #4, Nutshell
 Found Yellow Pine stump with scribing visible
 Set 5/8 inch X 30" Iron Rod, 24" in ground from which new Bts:
 A 13" Madrone bears S. $12^{\circ}30'$ E., 38.80 feet;
 * An 19" Madrone bears N. 30° W., 18.75 feet
 The corner is on a cat road and about 200 feet above old truck road.
- M. N.E. Corner of Tax Lot 1100
 Found 36" Douglas-fir on line which was original center post for Golden Octopus Claim; which tree is S. $87^{\circ}30'$ E., 19 feet from said N.E. Corner of Tax Lot 1100 (according to original survey notes)
 Set 5/8 inch X 30" Iron Rod 24" in ground for said N.E. Corner of Tax Lot 1100 from which:
 A 15" Madrone bears N. $70^{\circ}30'$ E., 29.55 feet and;
 An 11" Madrone bears N. $66^{\circ}30'$ W., 89.00 feet (in-between road to dump and road to shaft head), marked "N.E." on top blazes and "BT" on bottom blazes.
- N. Corner #3 A.N. King Claim
 Found Black Oak 6", now 10", chopped into and uncovered scribing
 Found rotted stump of 28" fir
 Set 5/8 inch X 30" Iron Rod 24" in ground from which the re-scribed 10" Black Oak bears N. $89^{\circ}30'$ E., 28.80 feet;
 An 8" Madrone bears S. $73^{\circ}30'$ W., 13.45 feet
 Top blazes scribed "3", bottom blazes scribed "BT"
 Corner is about 60 feet above road.

- G. Corner #3 of Admiral Dewey Claim (located by transit survey)
 Found 10" Douglas-fir, now 20" (exposed scribing)
 Found 36" Douglas-fir, now a windfall.
 Set 5/8 inch X 24" Iron Rod from which reblazed 10" fir (now 20")
 bears S. $27^{\circ}50'$ W., 21.29 feet; and a new 18" Douglas-fir BT
 bears N. 19° W., 26.95 feet.
 Corner is approximately 20' West of Bear Culch, across from road.
- H. Corner #4 Pelican
 Found 7" Madrone, now 14", chopped into and uncovered scribing
 Found Yellow Pine BT per notes, only stump remains.
 I set 5/8 inch Iron Rod X 24", 20" in ground from which a Douglas-
 fir scribed "4-414, BT" bears S. 32° E., 14.3 feet.
 Original Madrone, scribed "4-414, BT" bears N. $30^{\circ}43'$ E., 7.86 feet.
 A rock 8'x12'x18" is immediately East of corner which is approxi-
 mately 60 feet S.E. of a deep draw and approximately 80 feet S.W.
 of an opening which crosses the draw.
- I. Corner #4, California Claim
 Found stumps of both original BTs with scribing visible
 Set 5/8 inch Iron Rod X 30", 24" in the ground from which new BTs;
 A 12" Madrone bears S. 06° W., 23.70 feet (to center of root
 An 11" Douglas-fir bears N. 21° W., 23.35 feet collar)
 Corner is below old skid road approximately 100 feet.
- J. Corner #3, Golden Octopus
 Found original Douglas-fir BTs with scribing visible on original
 32" Douglas-fir.
 Set 5/8 inch X 30" Iron Rod from which new BTs are:
 A 11" Madrone bearing S. $51^{\circ}30'$ E., 18.70 feet
 A 12" Madrone bearing N. 47° W., 38.70 feet
 Both new BTs are on North (fill slope) edge of road.

- D. Corner #1 of Hope Claim (above mobile home)
 Found original 18" Madrone now 33" below fork
 Found original 6" Pine, now a stump hole with blaze-face slab
 with part of scribing visible in ruins.
 I reblazed Madrone now 33" below fork and scribe "569" in top
 blaze and "BT" on bottom blaze, which Madrone bears S. 14° E.,
 62.90 feet to center of root collar and;
 Establish a new 12" Madrone BT which bears S. 39° W., 16.4 feet
 scribed "596" in top blaze and "BT" on bottom blaze;
 From a 5/8 inch X 30" Iron Rod I set with a yellow plastic cap
 marked "Wickham" "RLS 664", exposed 6 inches.
 Metal tank nearby creates obvious local attraction to compass needle.
- E. Corner #3 of Pelican Claim (located from transit survey)
 Found stump of 40" fir
 Found rotted stump of 14" fir, with wood slabs containing scribing
 I set 5/8" X 24" Iron Rod 20" in the ground with cap reading "Wickham
 Pelican Corner 3 (W), RLS 664", on edge of cut-bank above road.
 From which I establish 2 new bearing trees:
 A Douglas-fir, 10" dbh, N. 59° 25' W. 21.10 feet
 A Madrone, 13" dbh (below coppice forks 1 foot above ground),
 N. 34° 00' E., 1.75 feet.
- F. Corner #2 of Pelican Claim (established from transit survey)
 Found root collar of original 12" Madrone BT with two 4" trees
 growing out of root collar.
 Set 5/8 inch X 24" Iron Rod from which new BTs
 An 8" Madrone bears N. 41° 30' E., 15.57 feet
 An 8" Madrone bears S. 46° 00' E., 27.70 feet; both scribed
 "414-2" on upper blaze and "BT" on lower blaze
 Corner is in middle of upper cut bank of road.

- A. Corner #2 of Hope Claim: set 5/8 inch Iron Rod X 24", 4" exposed
Found original Oak BT and exposed scribing
Found remains of original fir BT
Found 1 inch diameter Iron Pipe N. 9° W. 9.18 feet from corner position.
Corner is above (North) of cabin
I reblazed original Oak BT and scribed "2" on upper blaze and "BT" on lower blaze. The Oak bears N. $21^{\circ}30'$ W., 21.25 feet to center of root collar.
I established a new BT, a 10 inch diameter Madrone, which bears S. 32° E., 35.4 feet to the center of the root collar from the corner, scribed "2" on upper blaze and "BT" on lower blaze.
- B. Corner #3 of Hope Claim: set 5/8 inch Iron Rod X 24", 6" exposed
Found 24" fir BT, now 32" with blaze. Tree is burned but still alive.
Found 36" fir BT now a stump. Corner is approximately 300' S.W. of Bear Gulch on steep side hill.
I established new BTs - Measurements made to face of blaze
A 12" Madrone, N. $17^{\circ}30'$ E., 19.2 feet
An 8" Madrone, N. $75^{\circ}15'$ W., 27.9 feet, both scribed "3" on top blaze and "BT" on bottom blaze.
- C. Corner #4 of Hope Claim
Found mound of stone and rotted post.
Found 6" Madrone, now 22"
Found 12" fir, now a rotted stump with scrap of blaze and scribing.
Corner is approximately 300 feet N.E. of Bear Gulch on steep sidehill.
I re-established 22" Madrone above chopped out old blaze and scribed "4" in the new upper blaze and "BT" in a blaze on the root collar.
Madrone bears S. $15^{\circ}30'$ W., 7.7 feet to the face of the upper blaze.
I established a new 13" Douglas fir BT which bears N. $4^{\circ}30'$ W., 14.5 feet to the root collar from the new 5/8 inch Iron Rod monument.

January 1982

9212

DESCRIPTION OF RE-ESTABLISHED
MINERAL-SURVEY CORNER MONUMENTS

SECTION 12, TOWNSHIP 39 SOUTH, RANGE 1 WEST, WILLAMETTE MERIDIAN

Re-established corners are some of the corners established by U.S. Mineral Surveys 414, 569, and 377 during the years 1903 to 1906. Evidence showed bearing tree distances were taken from corner monuments (wooden posts) to the lower point of upper blazes. Consequently I perpetuated that system in measuring the distance to new bearing trees (unless otherwise noted). Each bearing tree is marked by two blazes; The upper blaze scribed with the number of that corner as recorded in the original mineral survey notes, and also the mineral survey number if the corner might be confused with a corner of another mineral survey; The lower blaze scribed with the letters "BT".

New corner monuments are 5/8 inch diameter rebar iron rods with yellow plastic caps. Caps are marked "Wickham" "RLS 664" unless otherwise noted herein. The iron rods are either 24 or 30 inches long, exposed 6 inches (unless otherwise noted).

Most of the bearings to new bearing trees were measured with a staff compass, using a 19 degree east declination. This narrative also records bearings measured by a transit from a traverse.

The position of old corner monuments were determined by measurements from original bearing trees. In most cases probing of the hard decomposed granit soil revealed the exact location of the original post. I found only two posts still partially preserved above ground. Corners without positive identification of original bearing trees were not re-established.

The attached survey plat shows corners located and they are designated "A,B,C," etc., which correspond to the following descriptions which are tied to the map with identical "A,B,C," etc. designations.

9212

SURVEY NARRATIVE

LOCATION: Section 12, Township 39 South, Range 1 West, Willamette Meridian, Jackson County, Oregon.

SURVEYED FOR: P.B. Wickham
P.O. Box 564
Grants Pass, OR. 97526

PURPOSE: To perpetuate mineral claim corners which control the location of boundary lines of P.B. Wickhams property. Additional mineral claim corners located in the course of this survey were monumented, and recorded here, as a public service; Also to provide control for a subsequent survey and construction of a topographic map which, together with existing plan and profile maps of the Ashland Mine's 2½ miles of underground workings, will allow construction of a three dimensional model needed for proposed mineral exploration projects.

METHOD: I ran a transit traverse from the N. 1/16 corner on Wagner Creek Road and tied-in the South and West corners of the Pelican Lode claim mineral survey 414. For a basis of bearings I made two separate observations of polaris during the course of the survey. This traverse was run with a K&E Paragon transit and 300-foot steel chain. Corners not immediately adjacent to the transit survey were approximately determined by hand-compass and chaining with a Silva Ranger Compass and K&E 300-foot steel chain. I then made a search for original corner monuments and/or assessories. If no certain evidence was found I did not re-rstablish the corner monuments. If one or more original bearing trees were located I set a 5/8 inch diameter iron rod with yellow plastic cap marked "Wickham RLS 664" and either perpetuated the original bearing trees with new blazes and scribing or established new bearing trees with blazes and scribing. The details of evidence found and new monuments and assessories follows: