

CASCADE VILLAGE UNIT NO. 8

MAP OF SURVEY  
 LOCATED IN  
 S.W. 1/4 of SEC. 16, T.36S., R. 1 W., W.M.  
 JACKSON COUNTY, OREGON  
 FOR  
**RALPH WALLIS**  
 and  
**ROBERT FREDINBURG**

HOFFBUHR/BATH & ASSOCIATES, INC.  
 219 N. OAKDALE MEDFORD, OREGON  
 BY: RICHARD L. BATH R.R.L.S. NO. 1069  
 SCALE: 1" = 100' MARCH 16, 1982  
 BASIS OF BEARING S/N 9177

- = Set 5/8" x 24" Iron Pin w/ Yellow Plastic Cap tagged "R. BATH L.S. 1069"
- = Fd. Monument per S/N 9177
- S/N = Survey No.

REGISTERED  
 PROFESSIONAL  
 LAND SURVEYOR

*Richard L. Bath*

OREGON  
 RICHARD L. BATH  
 No. 1069

\* \* RECEIVED \* \*

Date 3/30/82 Bysk

This survey consists of:  
1 sheet(s) Map  
1 page(s) Narrative

JACKSON COUNTY  
 SURVEYOR

0076

1069

SURVEY NO. 9238

SURVEY NARRATIVE TO COMPLY WITH PARAGRAPH 209.250  
OREGON REVISED STATUTES

SURVEY FOR: Ralph Wallis  
Robert Fredinburg  
4167 Independence School Rd.  
Medford, Oregon 97501

LOCATION: Southwest one-quarter (1/4) of Section 16,  
Township 36 South, Range 1 West, Willamette  
Meridian, Jackson County, Oregon



PURPOSE: To survey and monument the South line of the  
tract as described in Document No. 80-18771 of  
the Official Records. Also, to verify the  
location of monuments established per Survey  
No. 1964 and 9177.

PROCEDURE: Located existing monuments as shown on the attached  
map. Some monuments were adjusted slightly to conform to their re-  
cord positions with the resulting bearings and distances shown.

The South line of tract described in Document No. 80-18771 is  
parallel with and 140.00 feet North of the North right of way line  
of Falcon Street.

Basis of bearing: Survey No. 9177

March 16, 1982

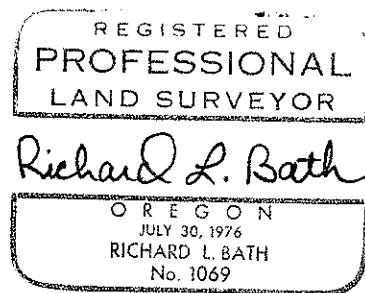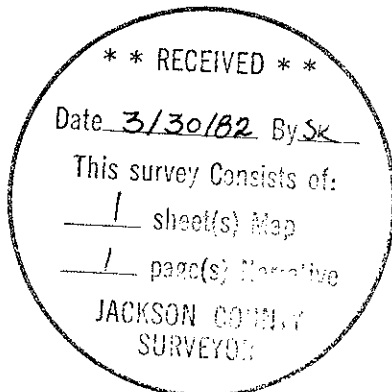

Richard L. Bath  
Hoffbuhr/Bath & Associates, Inc.  
219 North Oakdale  
Medford, Oregon 97501