

82-04790

406
2.25 Ind

POST MONUMENTATION PLAT for

THE OLD HELMAN RANCH SUBDIVISION

LOCATED IN THE N.W. 1/4 OF SECTION 4, T.39S., R.1E., W.M.
CITY OF ASHLAND, JACKSON COUNTY, OREGON.

SEPTEMBER 3, 1979

** RECEIVED **

Date 4/2/82 By SK

This survey consists of:

1 sheet(s) Map

0 page(s) Narrative

JACKSON COUNTY
SURVEYOR

I, Verlyn Thomas, a duly Registered Land Surveyor of the State of Oregon, do hereby certify that this map represents a survey made by me or under my direction and the monuments conform to O.R.S. 92.060.

Examined and approved this 11th day of March, 1982.

James H. Olson
City Surveyor

Filed for record this 2 day of April, 1982, at 2:50 O'Clock P.M. and recorded in the Official Records of Jackson County, Oregon.

Jay A. Rametes
Deputy

Waldene Terry
County Clerk




SCALE: 1" = 100'

● = Set Brass Cap in Monument Case

REGISTERED
PROFESSIONAL
LAND SURVEYOR

Verlyn Thomas
OREGON
MAY 13, 1980
VERLYN D. THOMAS
S.C.S.

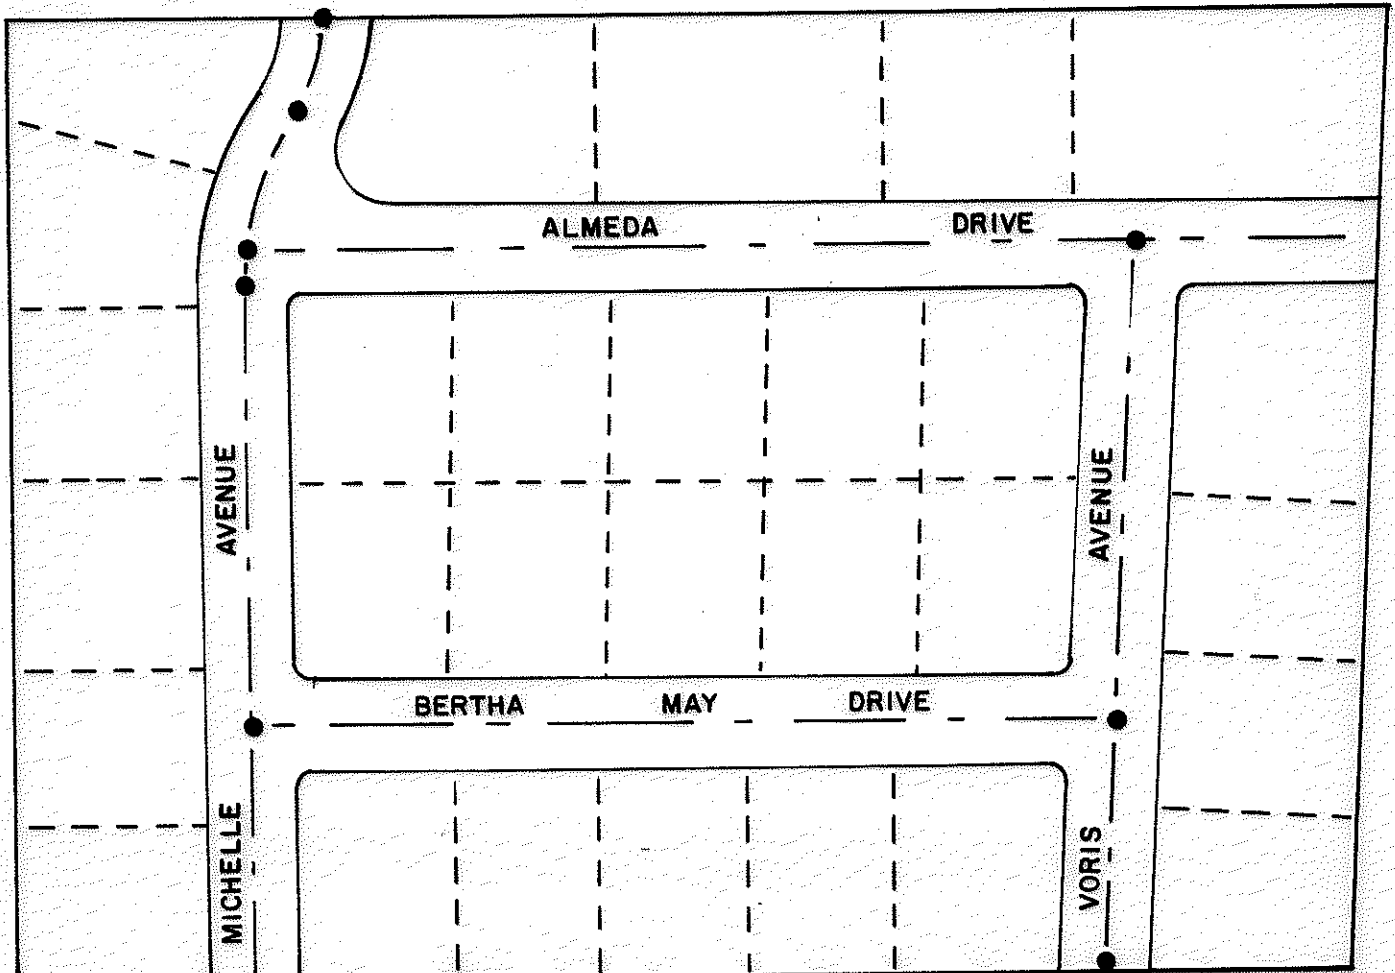

9247

9247