

COUNTRYWOOD SUBDIVISION UNIT 2

POSTMONUMENTATION MAP
LOCATED IN
S.W. 1/4 SEC. 8, T37S, R.1W, W.M.
CITY OF MEDFORD, JACKSON COUNTY, OREGON

I Dennis N. Hoffbuhr, duly registered Surveyor of the State of Oregon, do hereby certify that this map represents a survey made by me or under my direction, and that the monuments conform to requirements of O.R.S. 92.060 and to the locations as shown on the original plat of Countrywood Subdivision Unit 2.

Dennis N. Hoffbuhr
Surveyor

HOFFBUHR SURVEYING, INC. MEDFORD, OREGON
SCALE 1"=100' FEBRUARY, 1981

- = MONUMENTS FOUND PER ORIGINAL SUBDIVISION PLAT
- = SET 5/8" x 24" IRON PIN
- ⊙ = SET BRASS DISC
- ⊘ = SET 5/8" x 30" IRON PIN

FILED FOR RECORD THIS 10th DAY OF May 1981² AT
2:13 O'CLOCK P.M. AND RECORDED IN THE OFFICAL RECORDS
OF JACKSON COUNTY, OREGON

Walden Perry COUNTY CLERK
Ruby A. Poling DEPUTY

EXAMINED AND APPROVED THIS 8th DAY OF MAY, 1981.


Clair McBeck
CITY SURVEYOR

REGISTERED
PROFESSIONAL
LAND SURVEYOR

Dennis N. Hoffbuhr

OREGON
JULY 14, 1978
DENNIS N. HOFFBUHR
1640

RECEIVED
Date 5/10/82 BvSK
This survey consists of:
1 sheet(s) Map
0 sheet(s) Narrative
JACKSON COUNTY
SURVEYOR

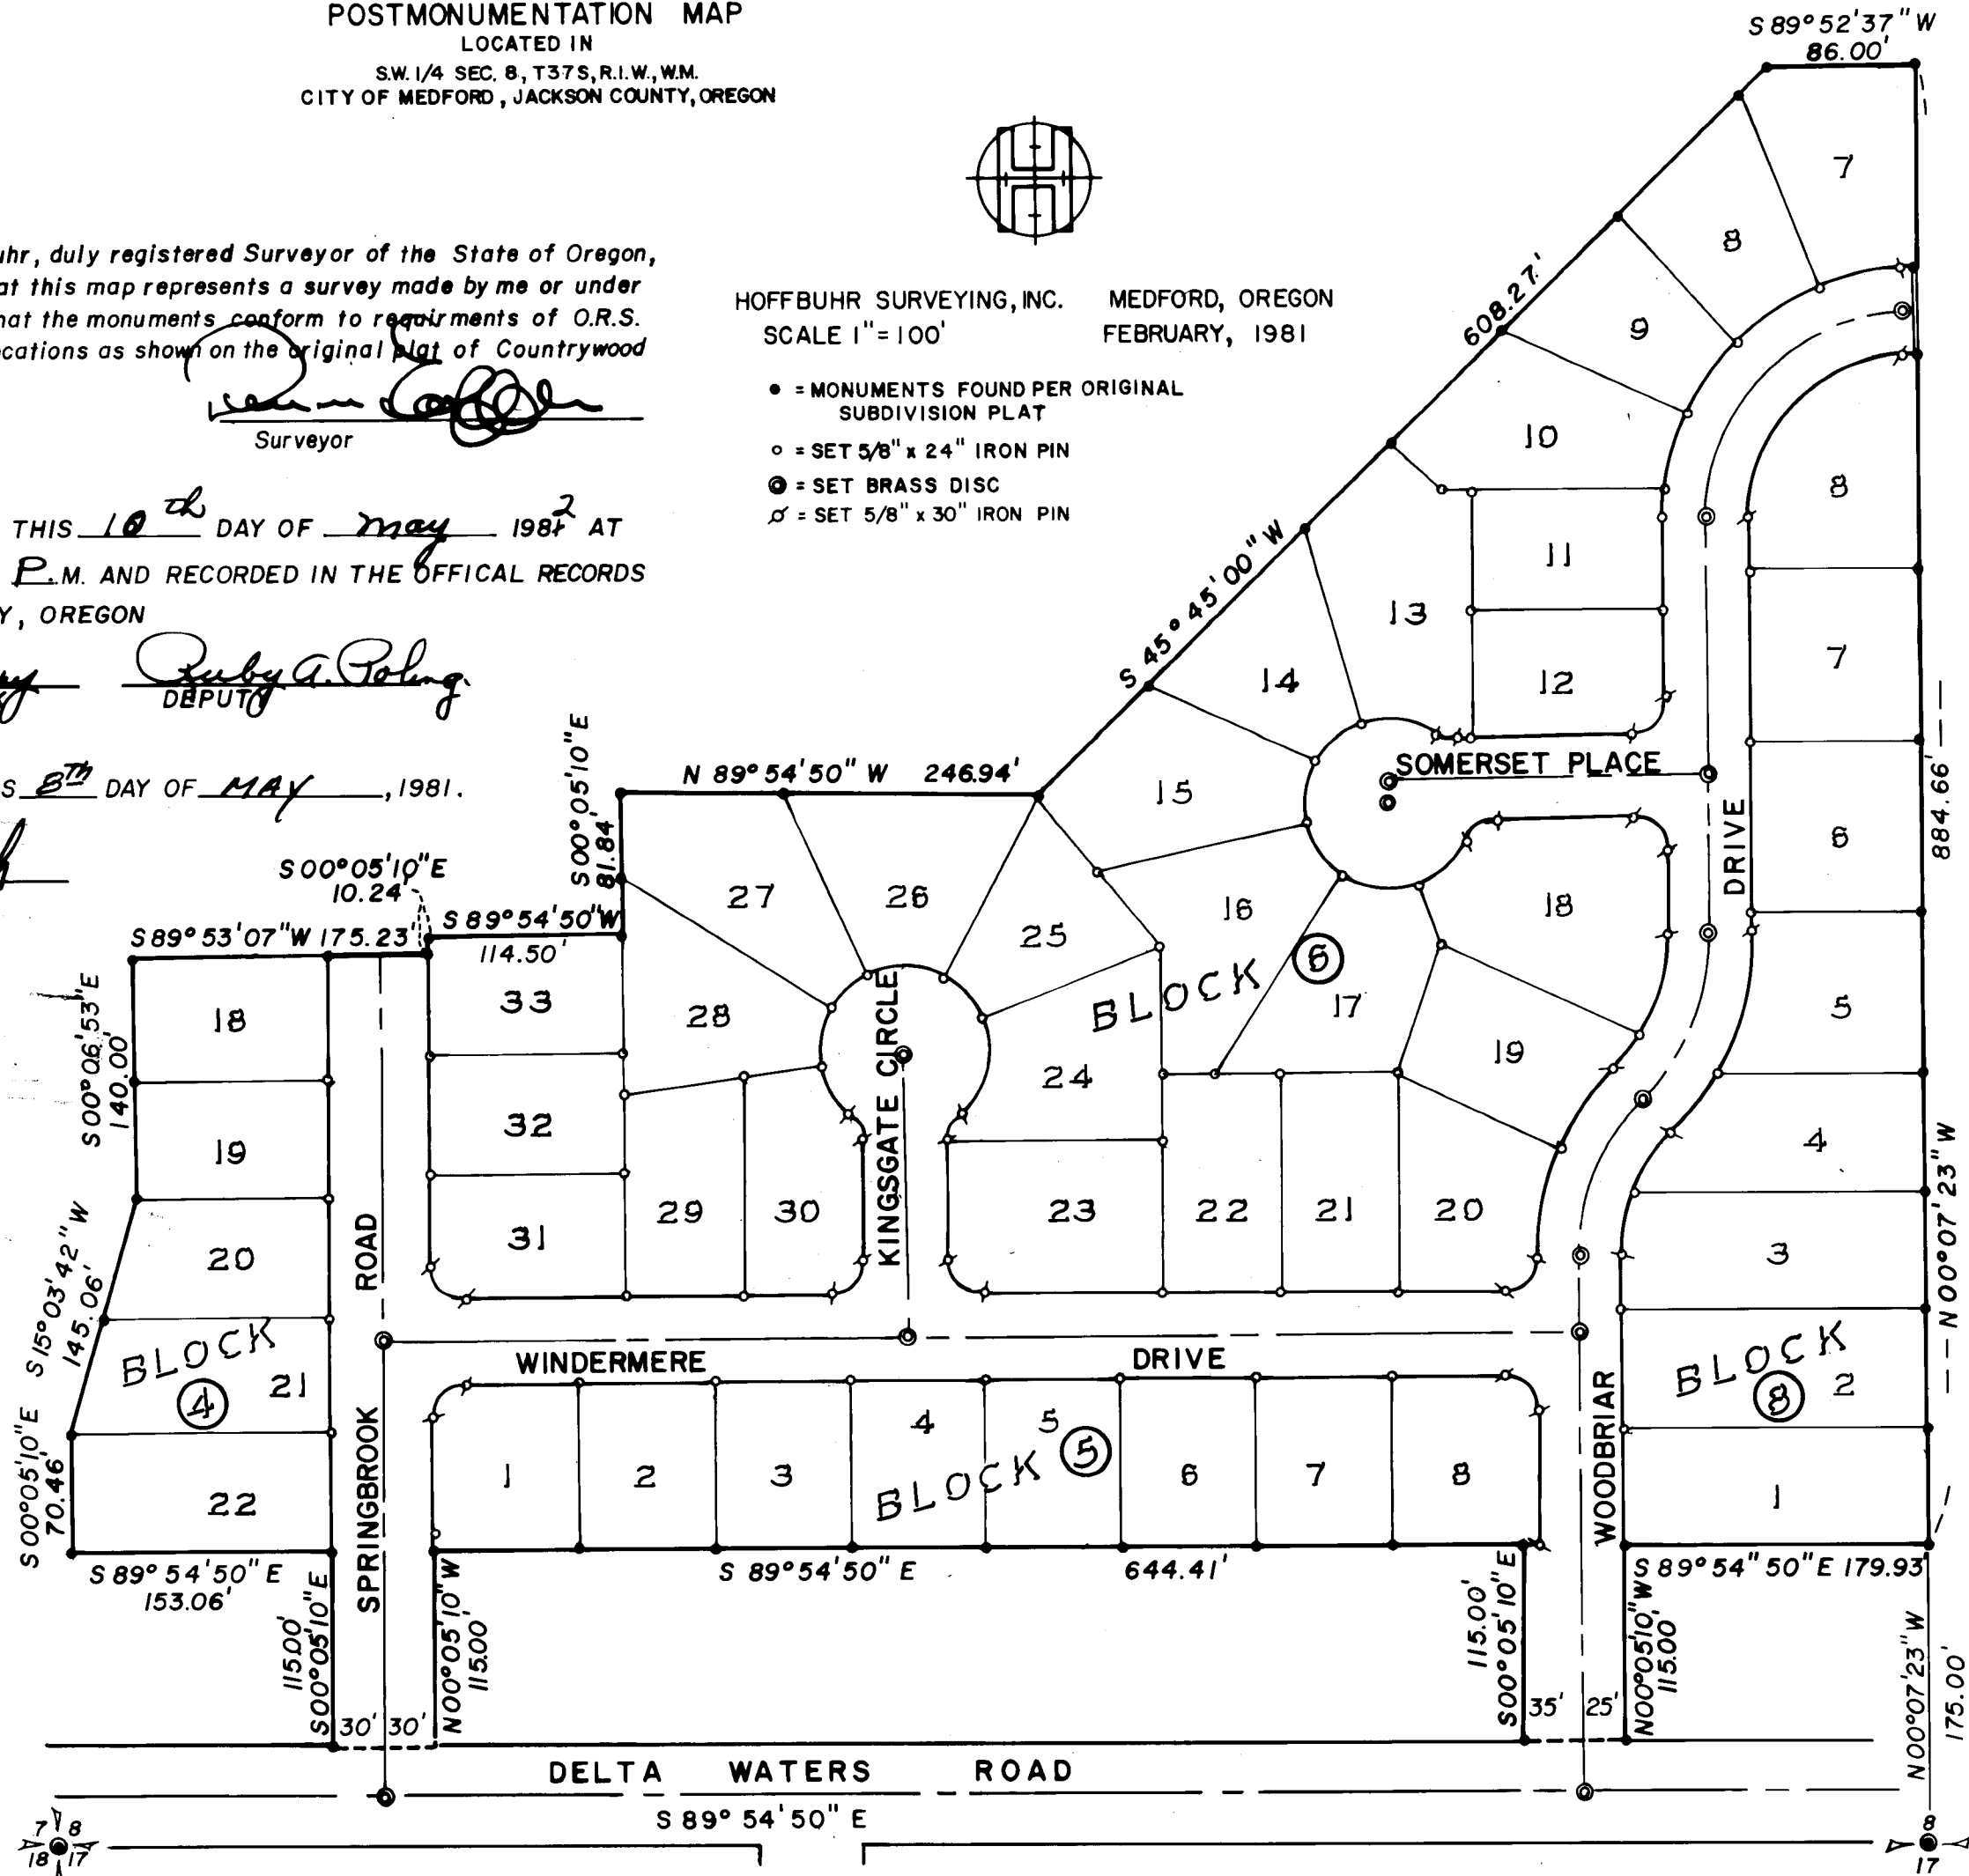

1186