


D.L.C. NO. 38  
N.W. COR.

# SURVEY TO ESTABLISH CORNERS OF CERTAIN PARCELS OF THE JOHN J. KIME PROPERTY IN THE SW 1/4 OF SECTION 22, T36S R4W, WM. MERIDIAN

SCALE: 1 INCH = 100 FEET

APRIL 20, 1982.

ROBT. M. THOMPSON & ASSOC.

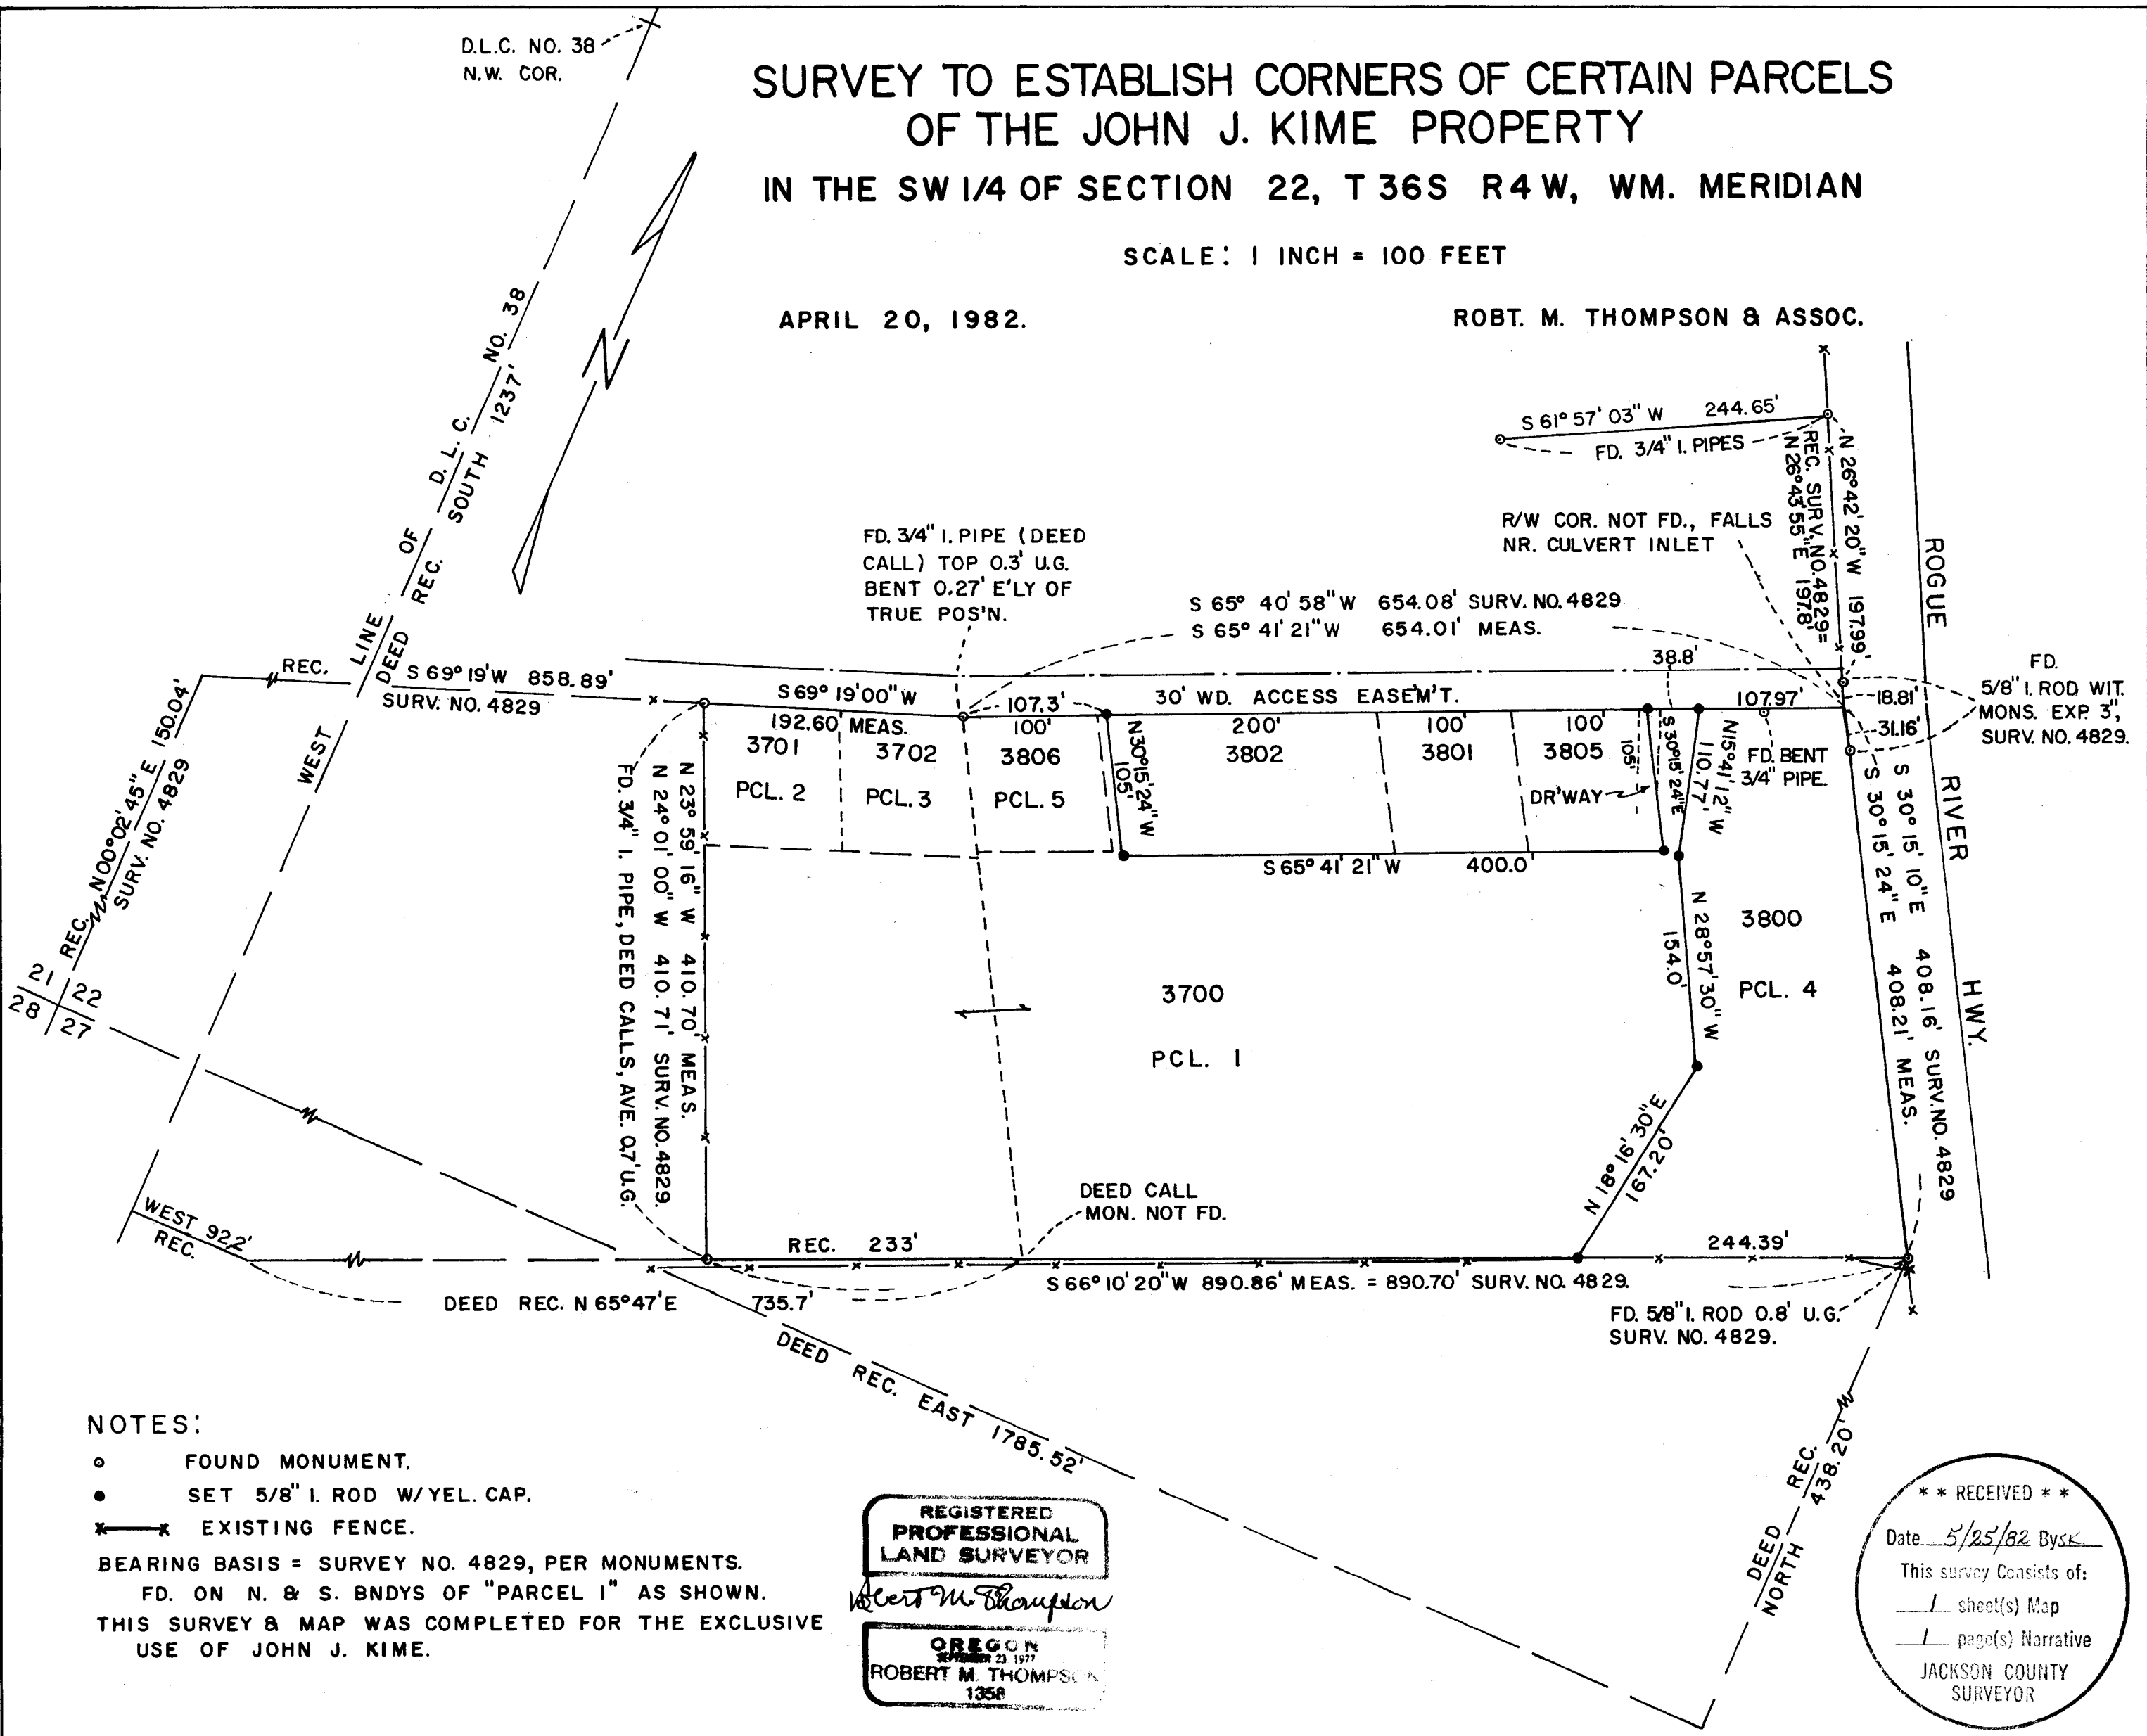

**NOTES:**

- FOUND MONUMENT.
- SET 5/8" I. ROD W/YEL. CAP.
- \*— EXISTING FENCE.

BEARING BASIS = SURVEY NO. 4829, PER MONUMENTS.  
 FD. ON N. & S. BNDYS OF "PARCEL 1" AS SHOWN.  
 THIS SURVEY & MAP WAS COMPLETED FOR THE EXCLUSIVE  
 USE OF JOHN J. KIME.

REGISTERED  
 PROFESSIONAL  
 LAND SURVEYOR

*Robert M. Thompson*

OREGON  
 SEPTEMBER 23 1977  
 ROBERT M. THOMPSON  
 1358

\*\* RECEIVED \*\*  
 Date 5/25/82 Bysk  
 This survey consists of:  
 — 1 sheet(s) Map  
 — 1 page(s) Narrative  
 JACKSON COUNTY  
 SURVEYOR

9289

SURVEY TO ESTABLISH CORNERS OF CERTAIN PARCELS OF THE JOHN J. KIME PROPERTY IN THE SW $\frac{1}{4}$  OF SECTION 22, T36S, R4W, WM. MERID., JACKSON COUNTY, OREGON


NARRATIVE DESCRIPTION TO COMPLY WITH PAR. 209.250, O.R.S.

FOR: John J. Kime, 4965 Rogue River Highway, Gold Hill, Oregon 97525

PURPOSE: To find and/or set corners of Parcel 4, and northerly corners of Parcels 1, 2, 3, and 5, as shown on my map.

PROCEDURE: The Kime Property description, as furnished by Mountain Title Company of Medford, consisted of 3½ pages of single-space typing, containing numerous parcels and exceptions. Previous Survey No. 4829 (in 1972) had found or set 5 exterior corners encompassing the exterior of the present Kime and other parcels, plus additional property corners lying northerly and westerly. This survey recovered several monuments that apparently originated in an unrecorded older survey. Some of said recovered monuments were called for in the Kime Property description, and as found in my survey, were driven to considerable depth. My survey began with a traverse around the exterior of the Kime and certain adjoining parcels, to recover all possible previously set monuments, and arrive at a basis for bearings. The best bearing basis compromise appeared to be a selection of that used by Survey No. 4829 for the Southerly boundary of Parcels 1 and 4, and the Northerly boundary of Parcels 2 and 3 (solar basis stated). Tax Lot Nos. 3801, 3802, and 3805 were described as exceptions to the Kime conveyance, with the intent being obvious to make their easterly and westerly boundaries parallel to the (Rogue River) Highway. After the necessary computing, parcel corner monuments were set as shown on my map.

April 20, 1982

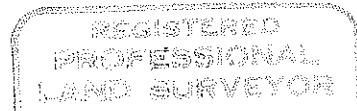

*Robert M. Thompson*

