

LEGEND:

- = SET 9/8" IRON PIN WITH PLASTIC CAP STAMPED FRIAR PLS 961
  - = FD. 5/8" IRON PIN
  - ⊙ = FD. MONUMENT AS SHOWN
- BASIS OF BEARING: SURVEY NO. 3647

MAP OF SURVEY  
FOR  
GILBERT PETER RYN

LOCATED IN LOT 2 BLOCK 2 MINGUS SUBN.  
IN THE SE. 1/4 OF SEC. 24, T. 37S., R. 2W., W.M.  
JACKSON CO. OREGON  
DATE: JUNE 8, 1982 SCALE: 1" = 100'

REGISTERED  
PROFESSIONAL  
LAND SURVEYOR  
*Larry J. Friar*  
OREGON  
JULY 16, 1971  
LARRY J. FRIAR  
961

\*\* RECEIVED \*\*  
Date 6/28/82 By SK  
This survey consists of:  
1 sheet(s) Map  
1 page(s) Narrative  
JACKSON COUNTY  
SURVEYOR

1/4 CORNER  
⊙  
FD. I. PIN IN  
MON. CASE

1.21'  
⊙  
FD. PUNCHMARK  
ON N.E. RIM OF  
MON. CASE

1/16 CORNER  
⊙  
FD. 3/4" I. PIN

SURVEY NARRATIVE TO COMPLY WITH O.R.S. 250

SURVEY FOR: Gilbert P. Ryn  
901 Narregan Street  
Medford, OR 97501

LOCATION: S.E. 1/4 of Section 24, T. 37 S.,  
R. 2 W., W.M., Jackson Co., Oregon.


PURPOSE: To monument certain corners of client's  
property as shown on the annexed map.

PROCEDURE: The subject parcel and adjoining parcels  
are described from the N.E. corner of  
Lot 2, Block 2, of Mingus Subdivision,  
which is located at the intersection of  
the West line of Narregan Street and the  
center line of Clark Street. After  
researching the old subdivision plats,  
more recent surveys, and making measurements  
between the found monuments, it was  
concluded that the location of the  
intersection of Clark Street and  
Narregan Street as monumented by Survey  
No. 5370 was the most probable location  
and was used as control to establish  
the corner monuments shown on the attached  
map.

Monuments found and set are as shown on the  
attached map.

Electronic equipment was used to measure  
distance shown.

DATE: June 10, 1982

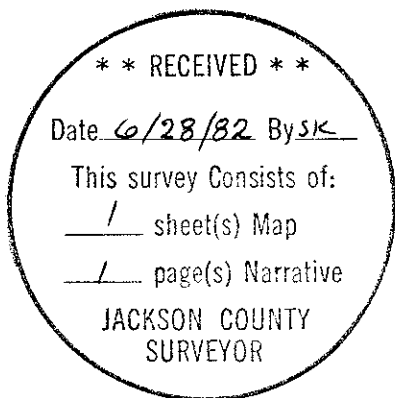

FRIAR-MOFFIT & ASSOCIATES  
717 West 10th, Suite 1  
Medford, OR 97501  
Phone: 503-772-2782

