

MAP

SHOWING A SURVEY IN THE SW 1/4 OF SECTION 14,
T. 35 S., R. 4 W., W.M., JACKSON CO., OREGON
AUG. 10, 1982


SCALE: 1" = 400'

SURVEYED FOR:

MIKE TRESEMER
6125 W. EVANS CREEK RD.
WIMER, OREGON

SURVEYED BY:

MAX H. HULL, SURVEYING
231 NW "B" STREET
GRANTS PASS, OREGON

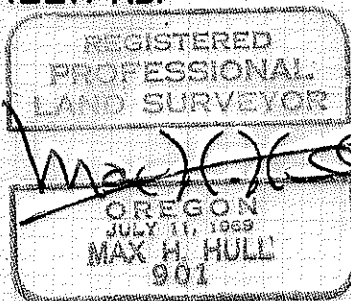

9365



MAX H. HULL Land Surveying

Office 476-2425

231 N. W. 'B' Street Grants Pass, Oregon 97526

SURVEY NARRATIVE to comply with Paragraph 209.250, O.R.S.

DATE: Aug, 10, 1982

FOR: Mike Tresemer
6125 West Evans Creek Road
Wimer, OR

PURPOSE: To survey the West and South boundaries and to mark the approximate North and East boundaries of the West 1/2, Southwest 1/4 of Section 14, Township 35 South, Range 4 West, Willamette Meridian, Jackson County, Oregon.

PROCEDURE: Beginning at the West 1/4 corner, at which point I found a brass cap from which I found:

A Black Oak 24" in diameter, South 46° East 46.2 feet
A Yellow Pine 33" in diameter, South 69° West 10.4 feet

Thence I traversed South 2661.44 feet to the Southwest section corner at which point I found a 1975 County Surveyor brass cap, from which I found:

A Black Oak 8" in diameter, North 51° East 24.42 feet
A Douglas Fir 8" in diameter, North 51° East 22.25 feet
A Madrone 11" in diameter, South 14° East 19.68 feet
A Black Oak 9" in diameter, South 87° West 39.57 feet
A Madrone 8" in diameter, North 61° West 23.55 feet

Thence I traversed South 89°28'26" East 2466.00 feet to the South 1/4 corner, at which point I found a 1956 County Surveyor brass cap from which I found:

A Laurel 8" in diameter, North 31° East 46.9 feet
A Black Oak 12" in diameter, South 68°30' East 10.7 feet

Thence I marked the approximate East and North boundaries as shown on the map.

Meridian is based on West line of said Section 14.

